

Property LINE DATE Sept 14, 1951 PARTY Beyerlein &

Ames ch

PROJECT Stake 100' N-S by 75' E-W

Parallel to 33<sup>1/2</sup> St & Johnson St.


KILHAM FORM P. 172-187286

--	--	--	--	--	--	--	--

College Avenue  
Block 8

For Fred C. Stone

9-15-51  
Regration  
Amco ch

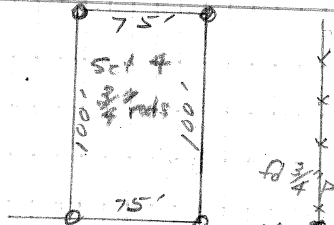

Johnson St

fd 1/2" p  
leans slightly S.  
Used at ground level

Cor of 1 1/2" p  
SW

2310



33rd St

fd 1/8 rod  
Block Cor.

Inc.

