

C.S. # 2339

Wilkin's Addition

Block 15

F.B. 84-113

Book 84

CITY & M

FIELD BOOK

861


113

Block 15 Wilkins Addition

Tulor St.

259.94

2339

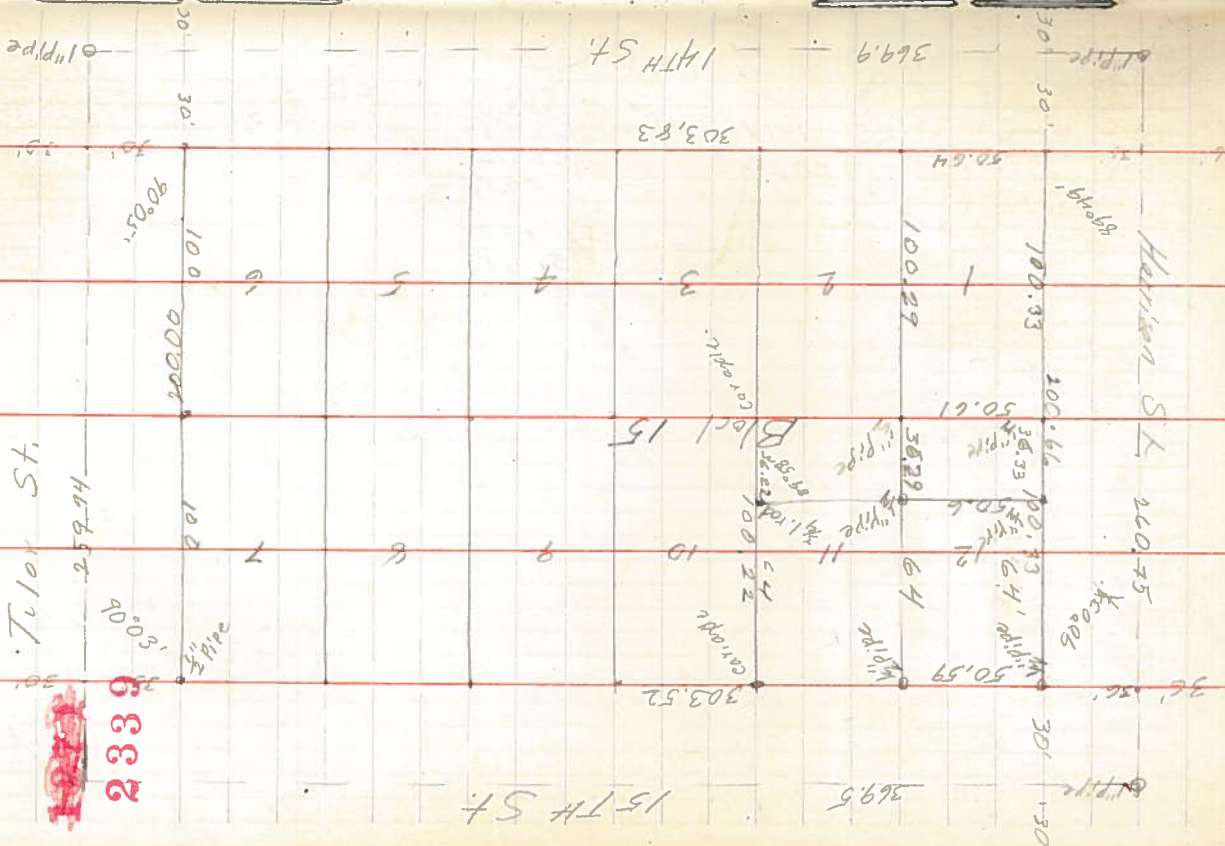

Feb or April 1936

.00108 = 3 1/2

3085

265.00

Libert Savings & Loan

61303.83

50.64

114

61303.52

50.59