

C.S. # 2340

Brown's Addition


Lot 1

F.B.



Farm Lot 1, Browns
Addn to Philomath

For Erb Kisor

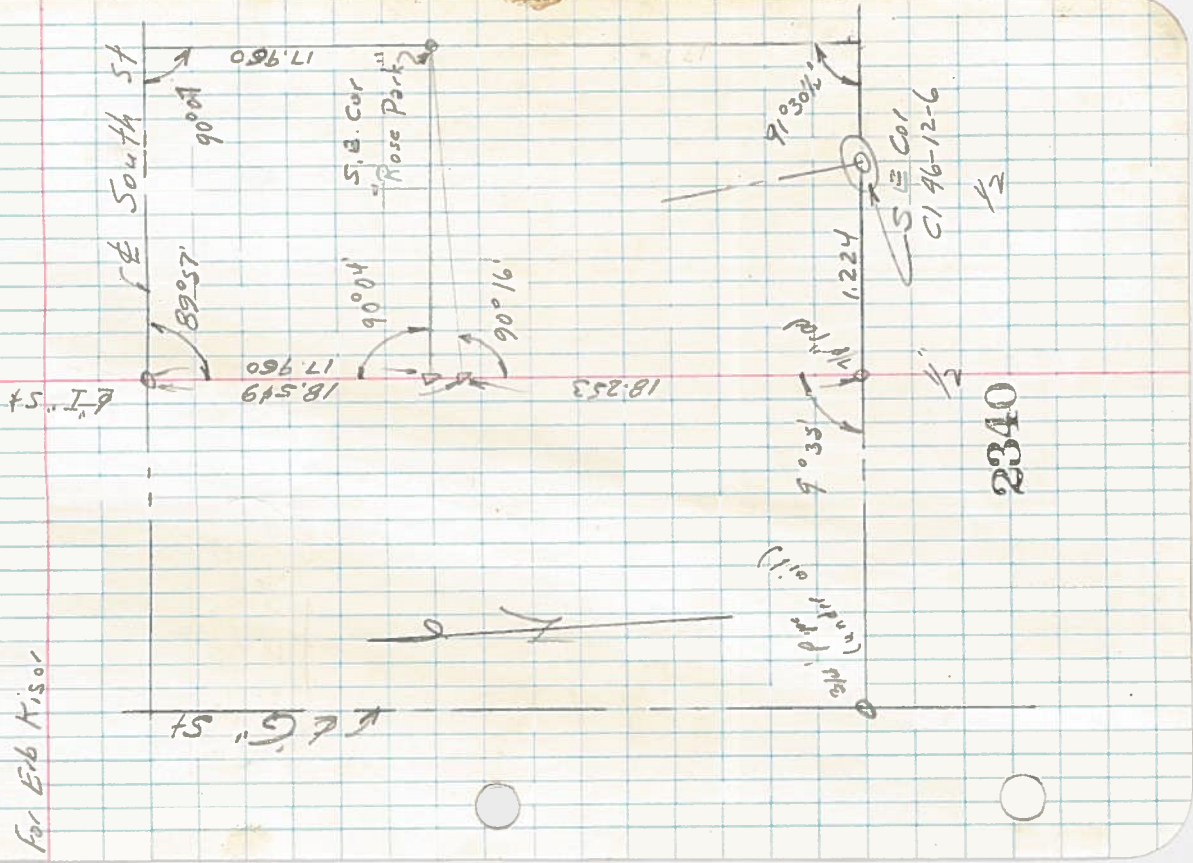

2340