


2303  
**C. F. RODGERS**  
 HEMAN LEWIS D.L.C.  
 T. 11 S., R. 5 W., W. M.  
 SCALE: 1" = 100'  
 FEB. 29, 1952

REGISTERED  
**OREGON**  
 LAND SURVEYOR

*Curtis C. Hanson*

NOVEMBER 14, 1945  
**CURTIS C. HANSON**  
 161

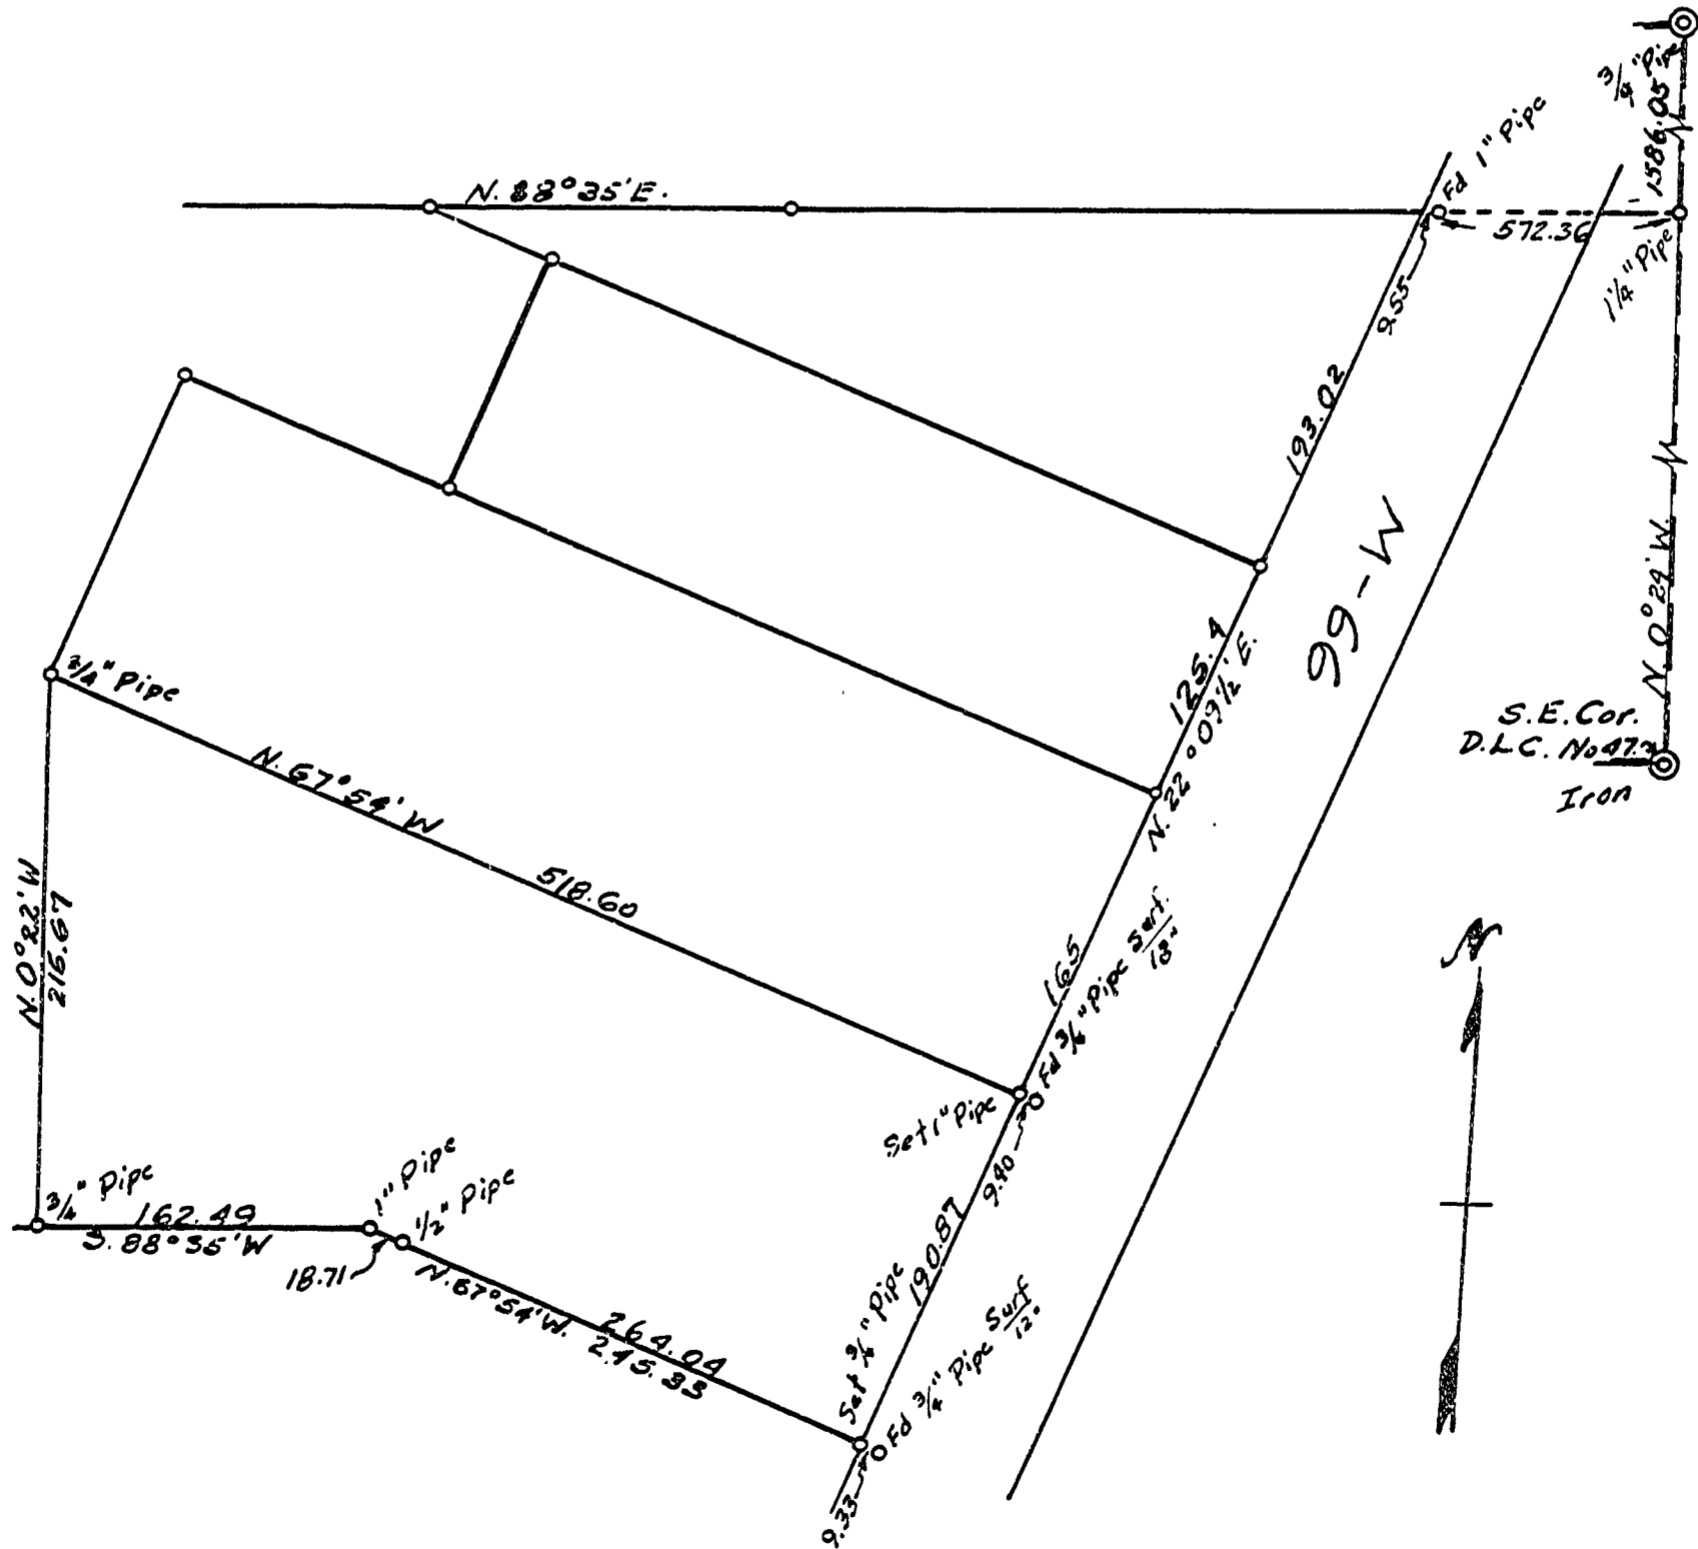


C1 47-11-5

CS # 52-18

2363

Fvt C. E. Rodgers

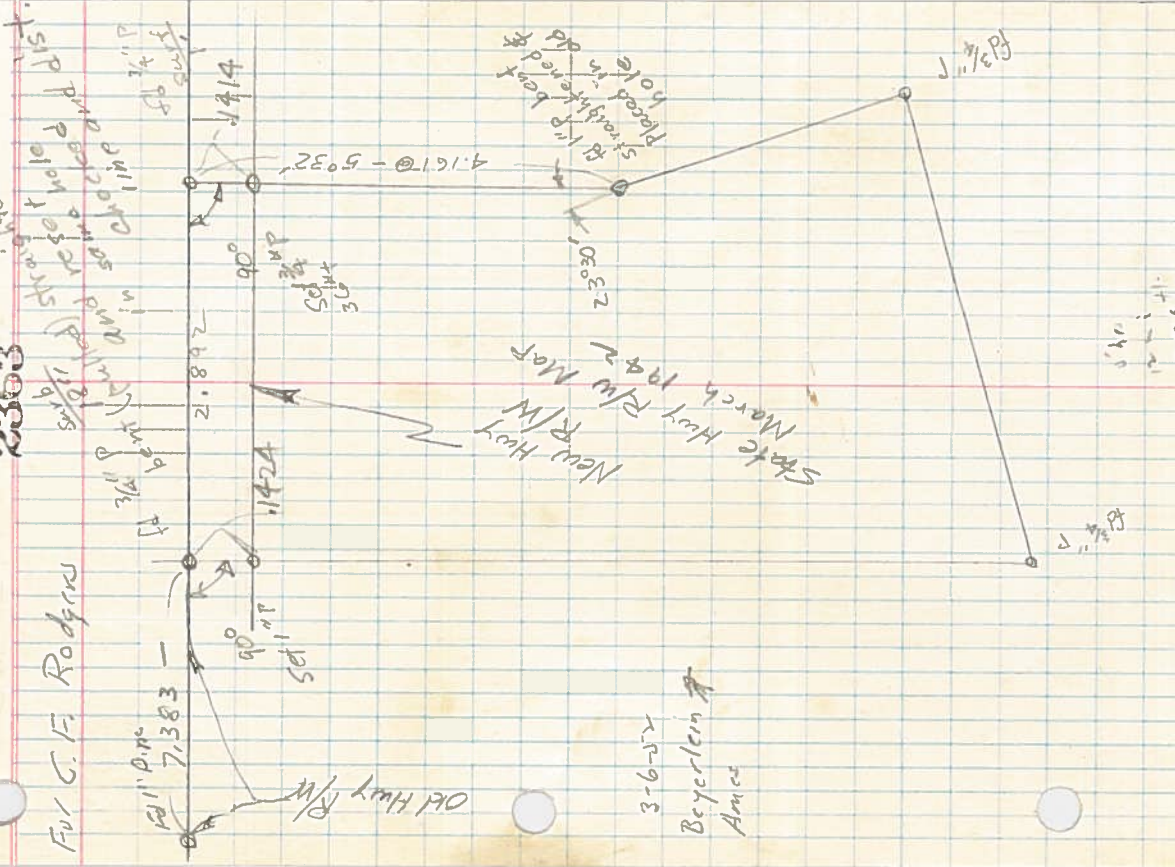

3-6-57  
Beyerlein  
Amice