

2370

IVAN LEBOLD
SECS. 20 & 21, T. 11 S., R. 5 W., WIL. MER.


Scale: 1" = 400'

MAY 19, 1952

REGISTERED
OREGON
LAND SURVEYOR

Curtis C. Hanson

NOVEMBER 9, 1945
CURTIS C. HANSON
161

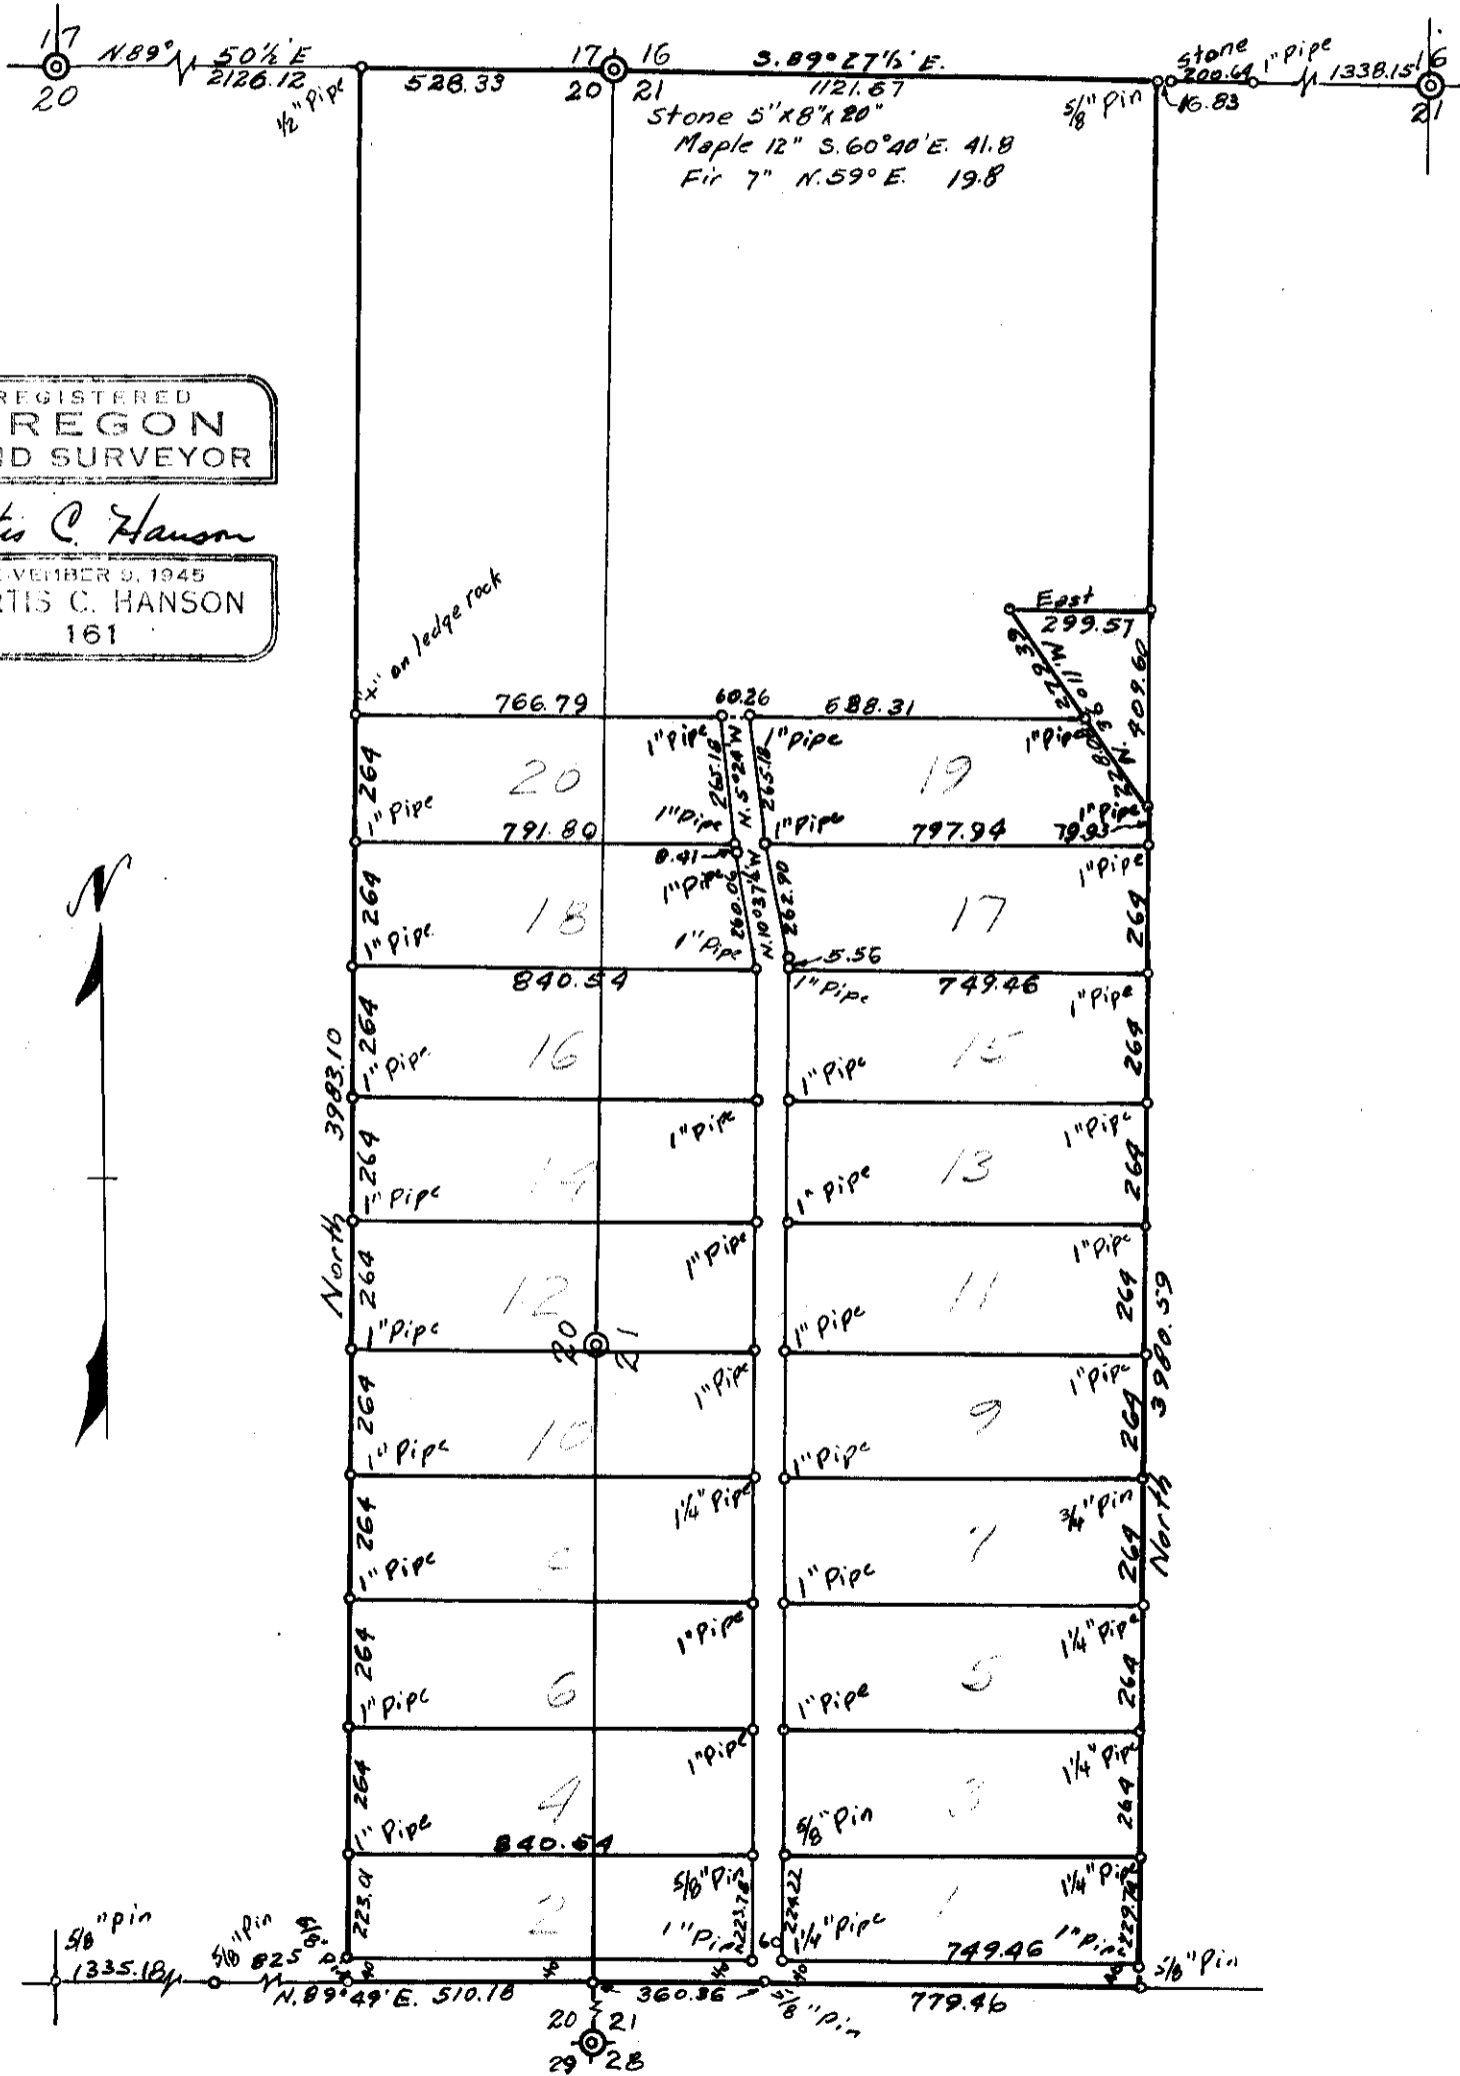

LINE DATE _____ PARTY _____

PROJECT Ivan Is. Is. Is.

KILHAM FORM P. 172 - 187286

267 15' S side db, 24" oak 550
 200' 00' E side of 10' oak 834
 85' 00' N side of 23" oak 231

Set Δ (bent nail in rock ledge
 0.002 -

4.110 +1326' 3,998

Set Δ "P

.019

0

4.055 +1100'

-

taken p. 50.

Δ_3

.863 -


3.177 +9004' 3,137

Δ_2

-.087

4.163 +1058' 4,087

Δ_1

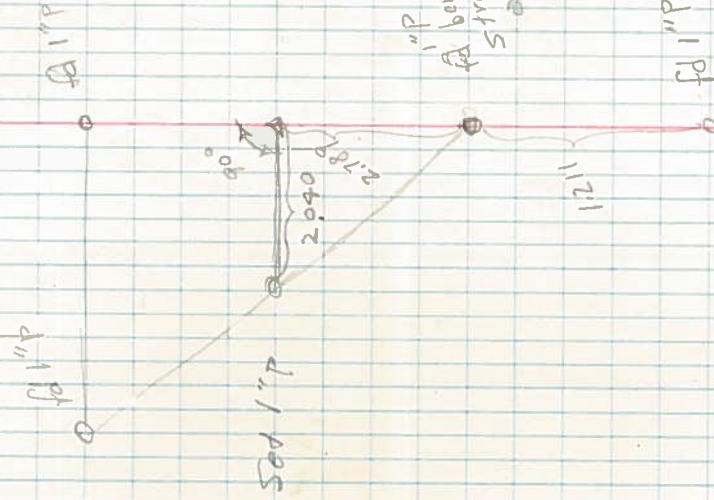

"P bent, ignored
 straight set
 and

LINE DATE

PARTY

PROJECT

KILHAM FORM P. 172 - 187286

Set 17p

2040

—

4th R1

90°

2.790

2.790

P

1.222

-8°03'

1.210

Op