



2335

# KENT FERRIS

LOT 4, BLOCK 2 - TINKHAM TRACTS  
CORVALLIS, OREGON

SCALE: 1 in = 50 ft.

July 7, 1952.

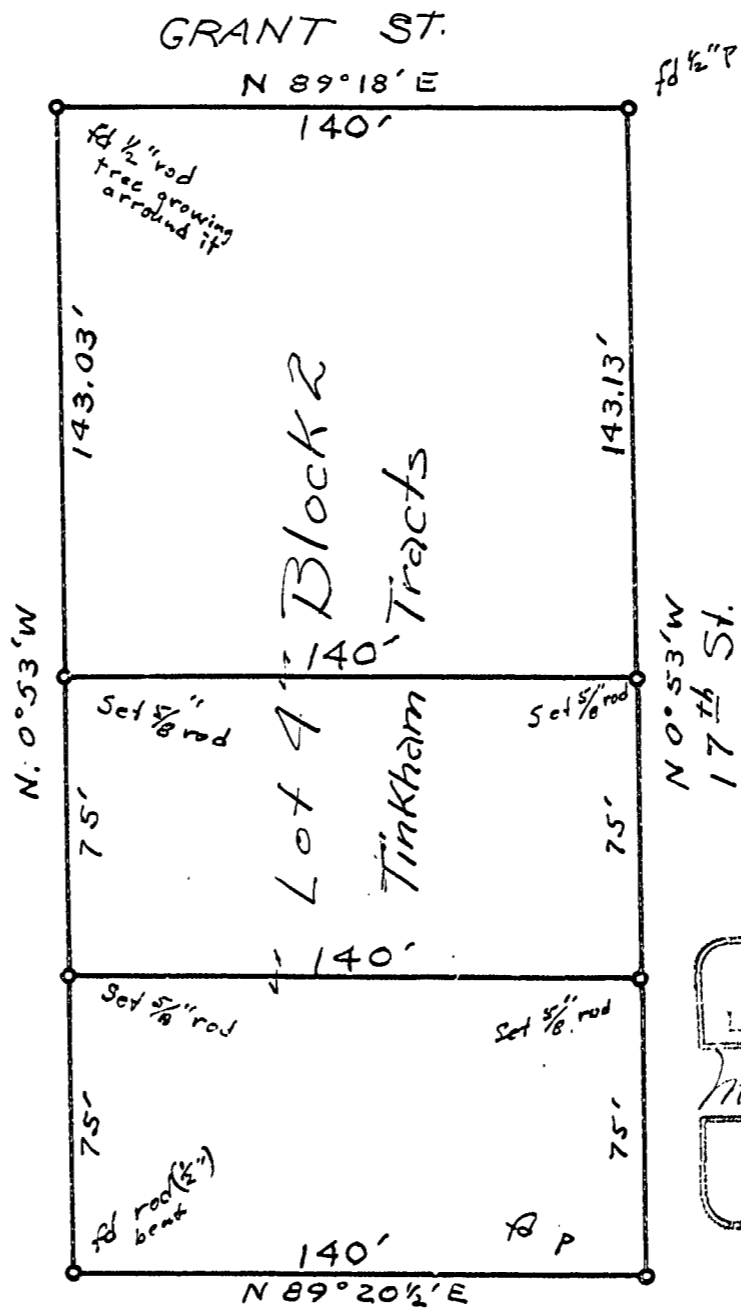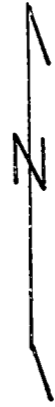

REGISTERED  
OREGON  
LAND SURVEYOR  
*Martin L. Beyerlein*  
NOV. 5, 1948  
MARTIN L. BEYERLEIN  
247



Blk 2 Timkham Tracts 4 hr  
 G.S. # J2-54 1 trip  
 2399 4 rods

