


2406

HARRISON ST.

13th ST.

12th ST.

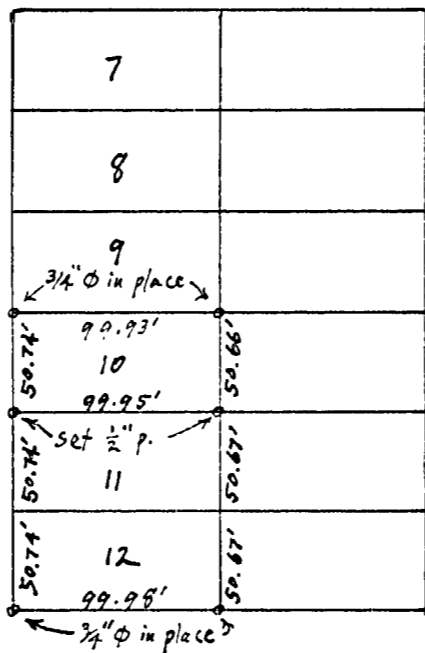

VAN BUREN ST.

1" = 100'

SURVEY OF LOT 10, BLOCK 12
WILKINS ADDITION
Corvallis, Oregon

Surveyed Oct. 26, 1951
For Mrs. J. G. Northrop



2406