

MRS. JOE BASSELIN

LOT 3 BLOCK 3, CHASE'S FIRST ADN. TO CORVALLIS

Scale: 1" = 20'

October 7, 1952


2427

REGISTERED
OREGON
LAND SURVEYOR

Martin L. Beyerlein

NOV. 5 1948
MARTIN L. BEYERLEIN
247

Deq. C. S.

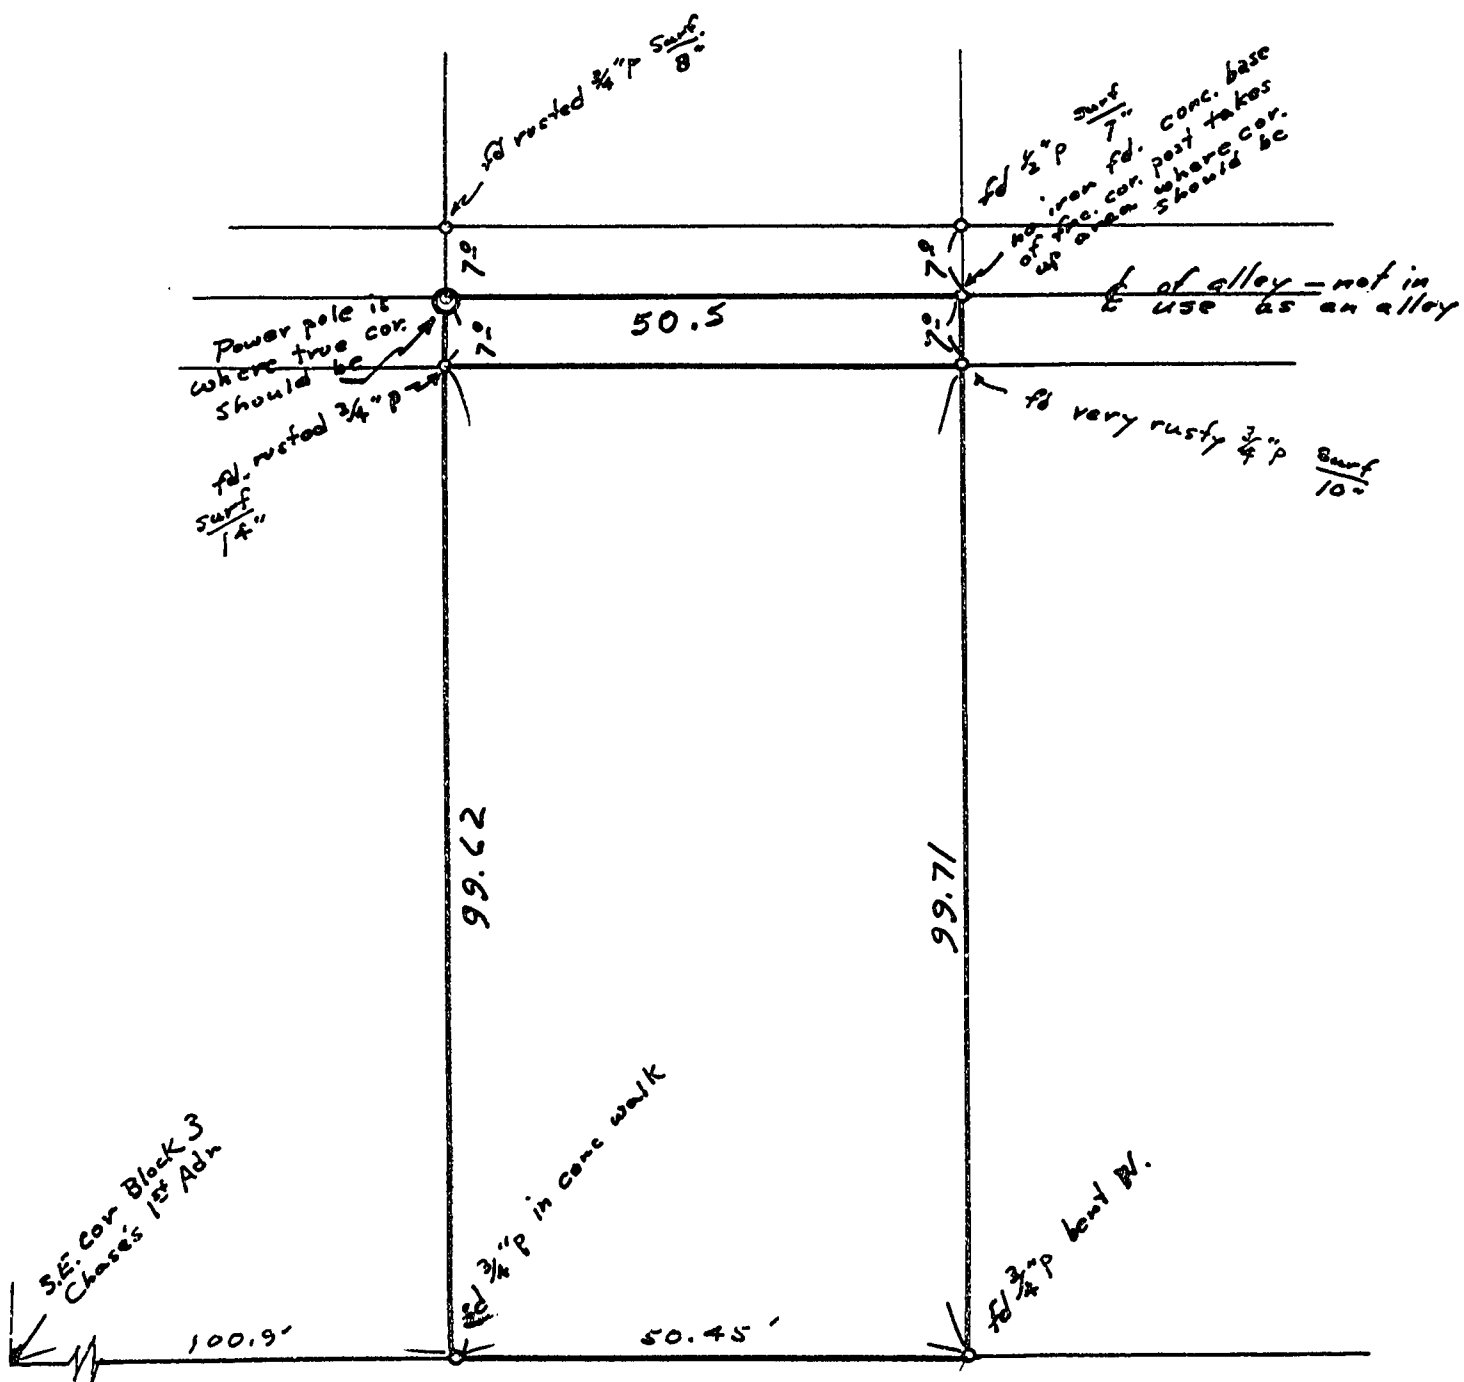

MRS. JOE BASSELIN
LOT 3 BLOCK 3, CHASE'S FIRST ADM. TO CORVALLIS

Scale: 1" = 20'

October 7, 1952

2427

REGISTERED
OREGON
LAND SURVEYOR

Martin L. Beyerlein

NOV. 5, 1948
MARTIN L. BEYERLEIN
247

Deq. C. S.

