

THOMAS E. NEER

WESTERN ADDITION, BENTON COUNTY, OREGON, T. 12 S., R. 5 W. W. M.

LOT 1, BLOCK 2, WESTERN ADDITION

I hereby certify that I surveyed the herein described property and that I find the improvements set thereon to be on the premises in question and that they do not overlap or encroach on the property lying adjacent thereto except as shown on the map.

I further certify that the walls and projections of buildings on adjacent property do not encroach on the property described herein.


The attached map shows a true and correct relation of the building to the property lines and the street.

I have checked the building restrictions applicable to this property and find there is no violation of the setback line.

There is no street number.

REGISTERED  
OREGON  
LAND SURVEYOR  
*Martin L. Beyerlein*  
NOV. 5, 1948  
MARTIN L. BEYERLEIN  
247

*March 17, 1953*

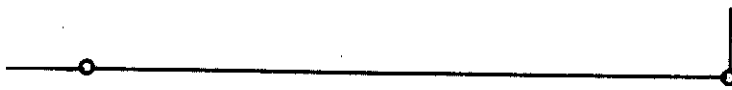

60'



60'

*Neer Ave.*

60'

