



GORDON LARSON

&

C. H. HILTON

BLOCK 19, PHILOMATH, OREGON.

SCALE: 1 in. = 50 ft. 2490 June 18, 1953.

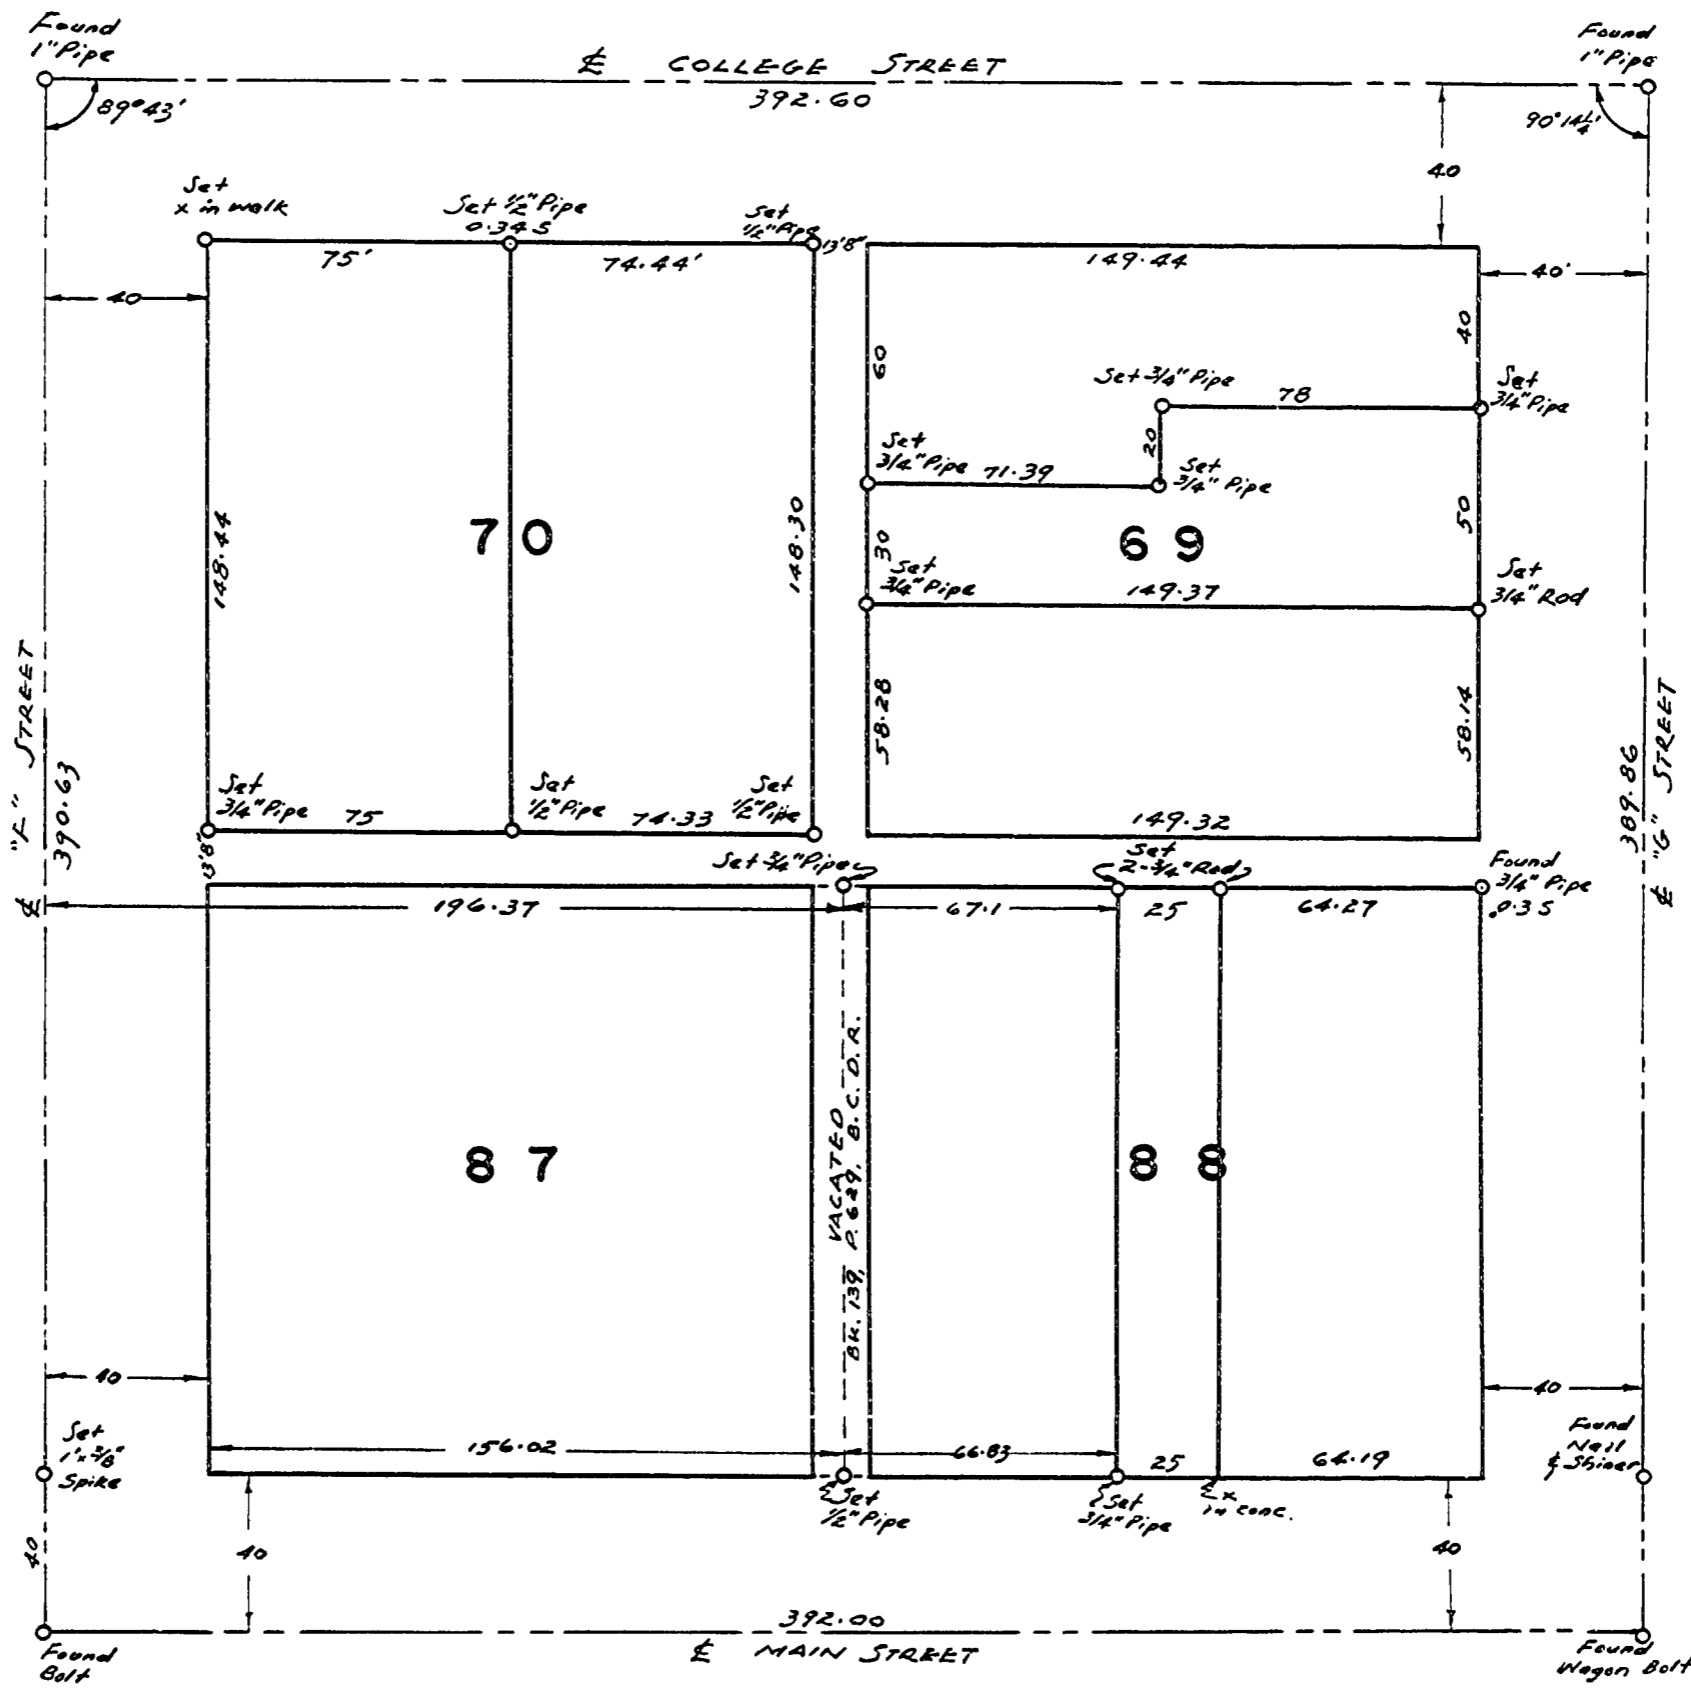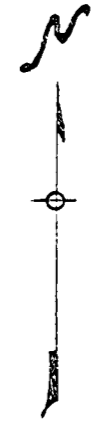

REGISTERED
OREGON
LAND SURVEYOR
Martin L. Beyerlein
NOV. 5, 1948
MARTIN L. BEYERLEIN
247
Dep. C.S.