
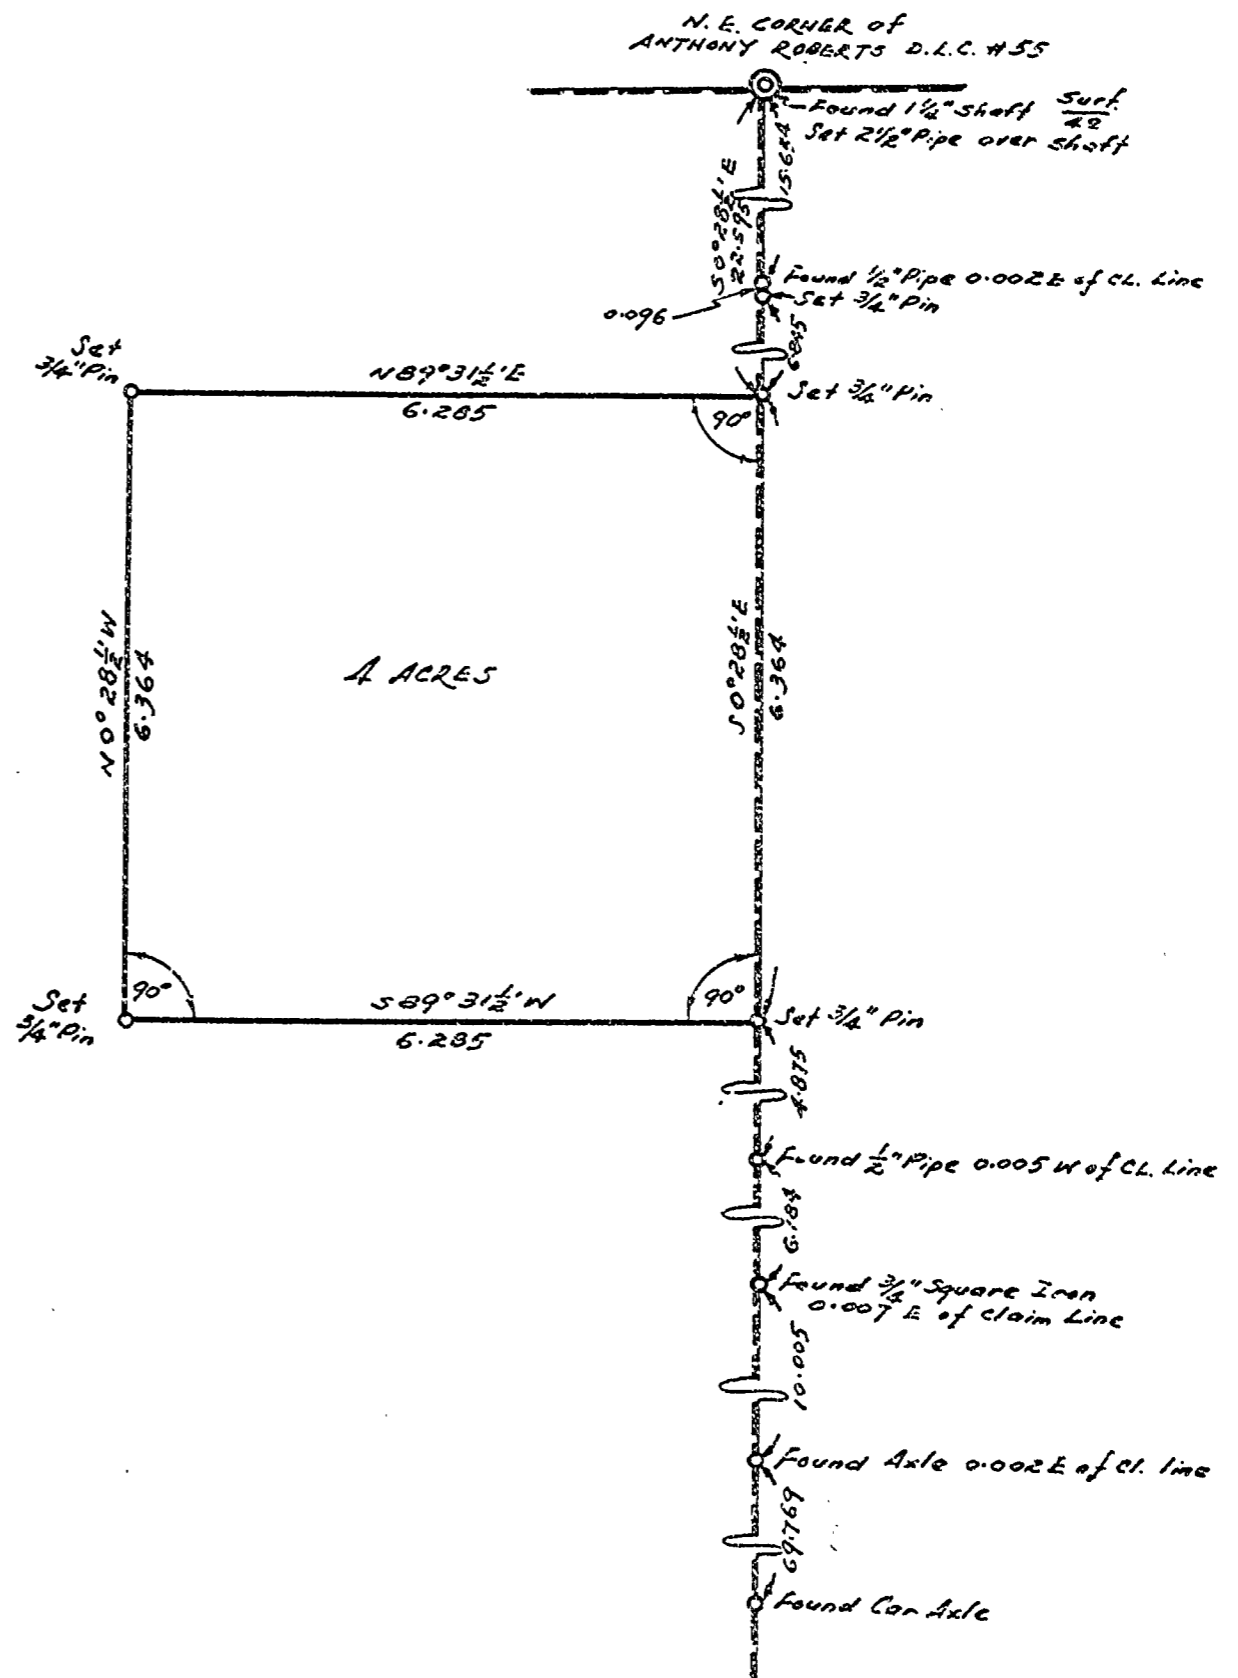


JULIUS H. BIEGEL  
 ANTHONY ROBERTS D.L.C.55, T.10S., R.4W., W.M.  
 SCALE: 1in. = 2ch. 2510 AUGUST 22, 1953.

REGISTERED  
 OREGON  
 LAND SURVEYOR

*Curtis C. Hanson*

NOVEMBER 9, 1943  
 CURTIS C. HANSON  
 161

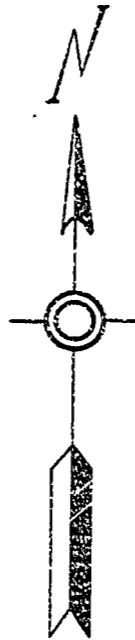

C/ 55-10-4

2510

8-24-53

~~4~~ ↑

Yes

For Julius Biered


LINE DATE \_\_\_\_\_ PARTY \_\_\_\_\_

PROJECT \_\_\_\_\_

KILHAM FORM F. 172 - 107286

10	15.923	-	15.923
9	16.073	-	16.073
8	7.066	-	7.066
7	8.000	-	8.000
06	7.855	-1°	7.854
	8000	-1°13	7.998
05	10010	-1°39	10.006
04	6.040	-1°43	6.037
03	6.560	-2°05'	19.510
	8000	+2°05'	3639
	3.640	+1°33'	
02	15.738	-	15.738
01			

2510

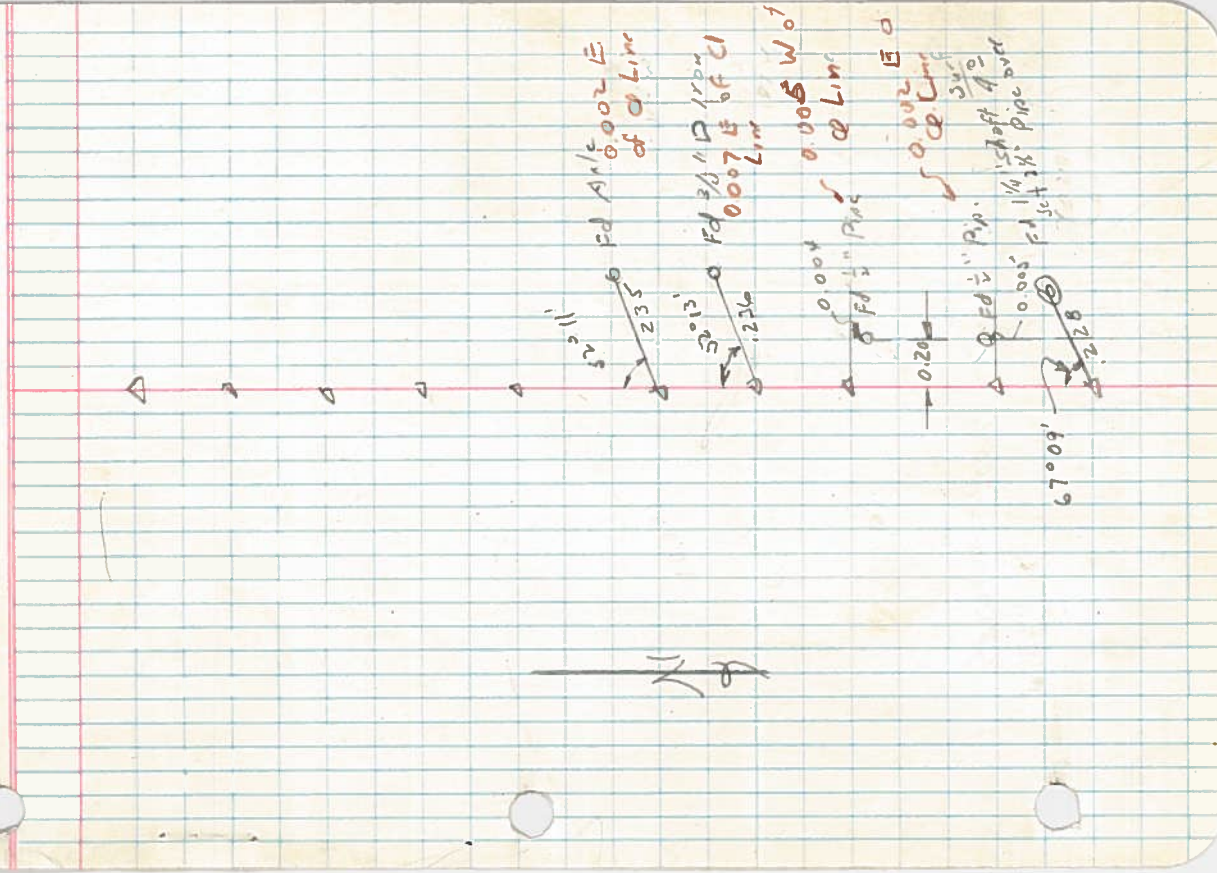


2510

LINE DATE ..... PARTY .....

PROJECT

KILHAM FORM F-172 187286

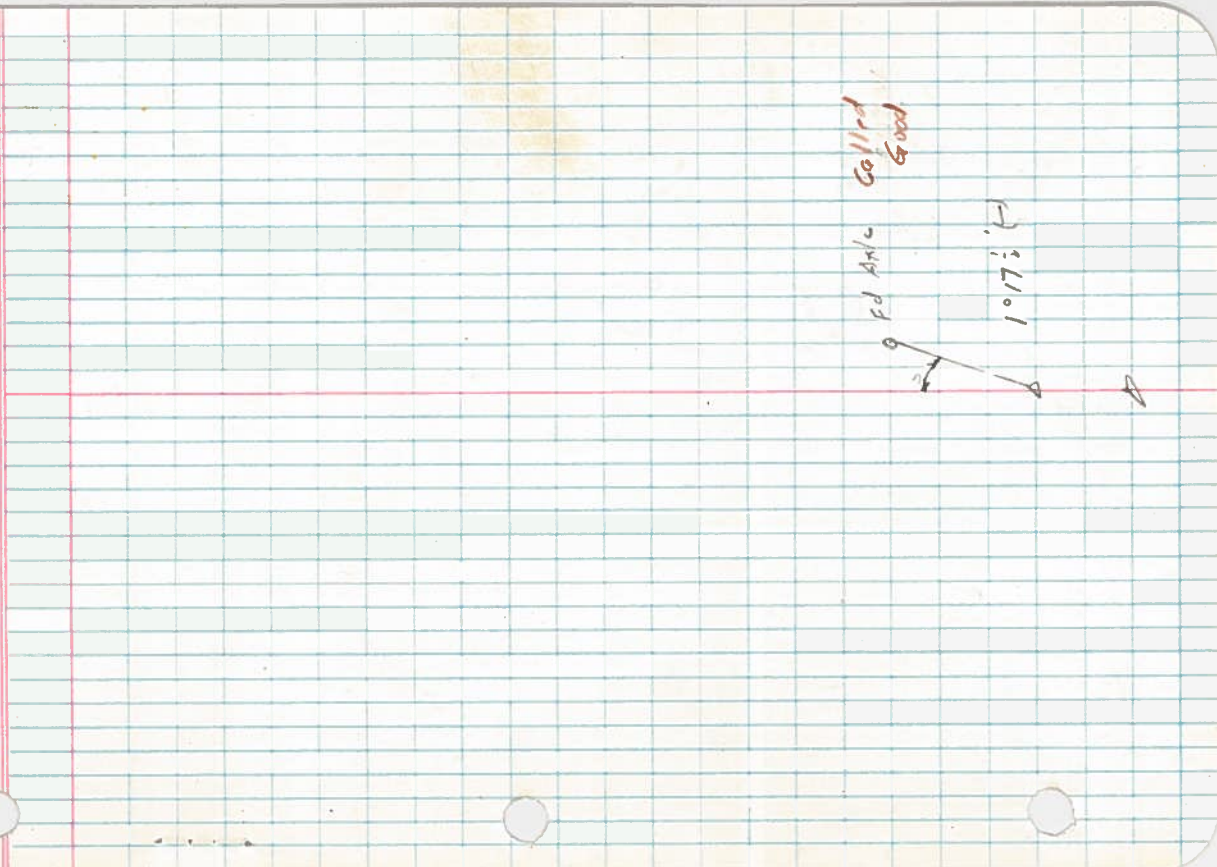

Ask  
 7.005 - 7.005 7.002 70  
 810 R11°17'16"  
 09

PROJECT \_\_\_\_\_

LINE DATE \_\_\_\_\_

PARTY \_\_\_\_\_

PROJECT

KILHAM FORM P-172 187286

