

FLOYD SANDERS

H. C. LEWIS D.L.C. No. 47, TWP. 11 S., R. 5 W., WILL. MER.


Scale: 1" = 40'

2545 FEBRUARY 13, 1954

REGISTERED
OREGON
LAND SURVEYOR

Curtis C. Hanson

NOVEMBER 9, 1945
CURTIS C. HANSON
161

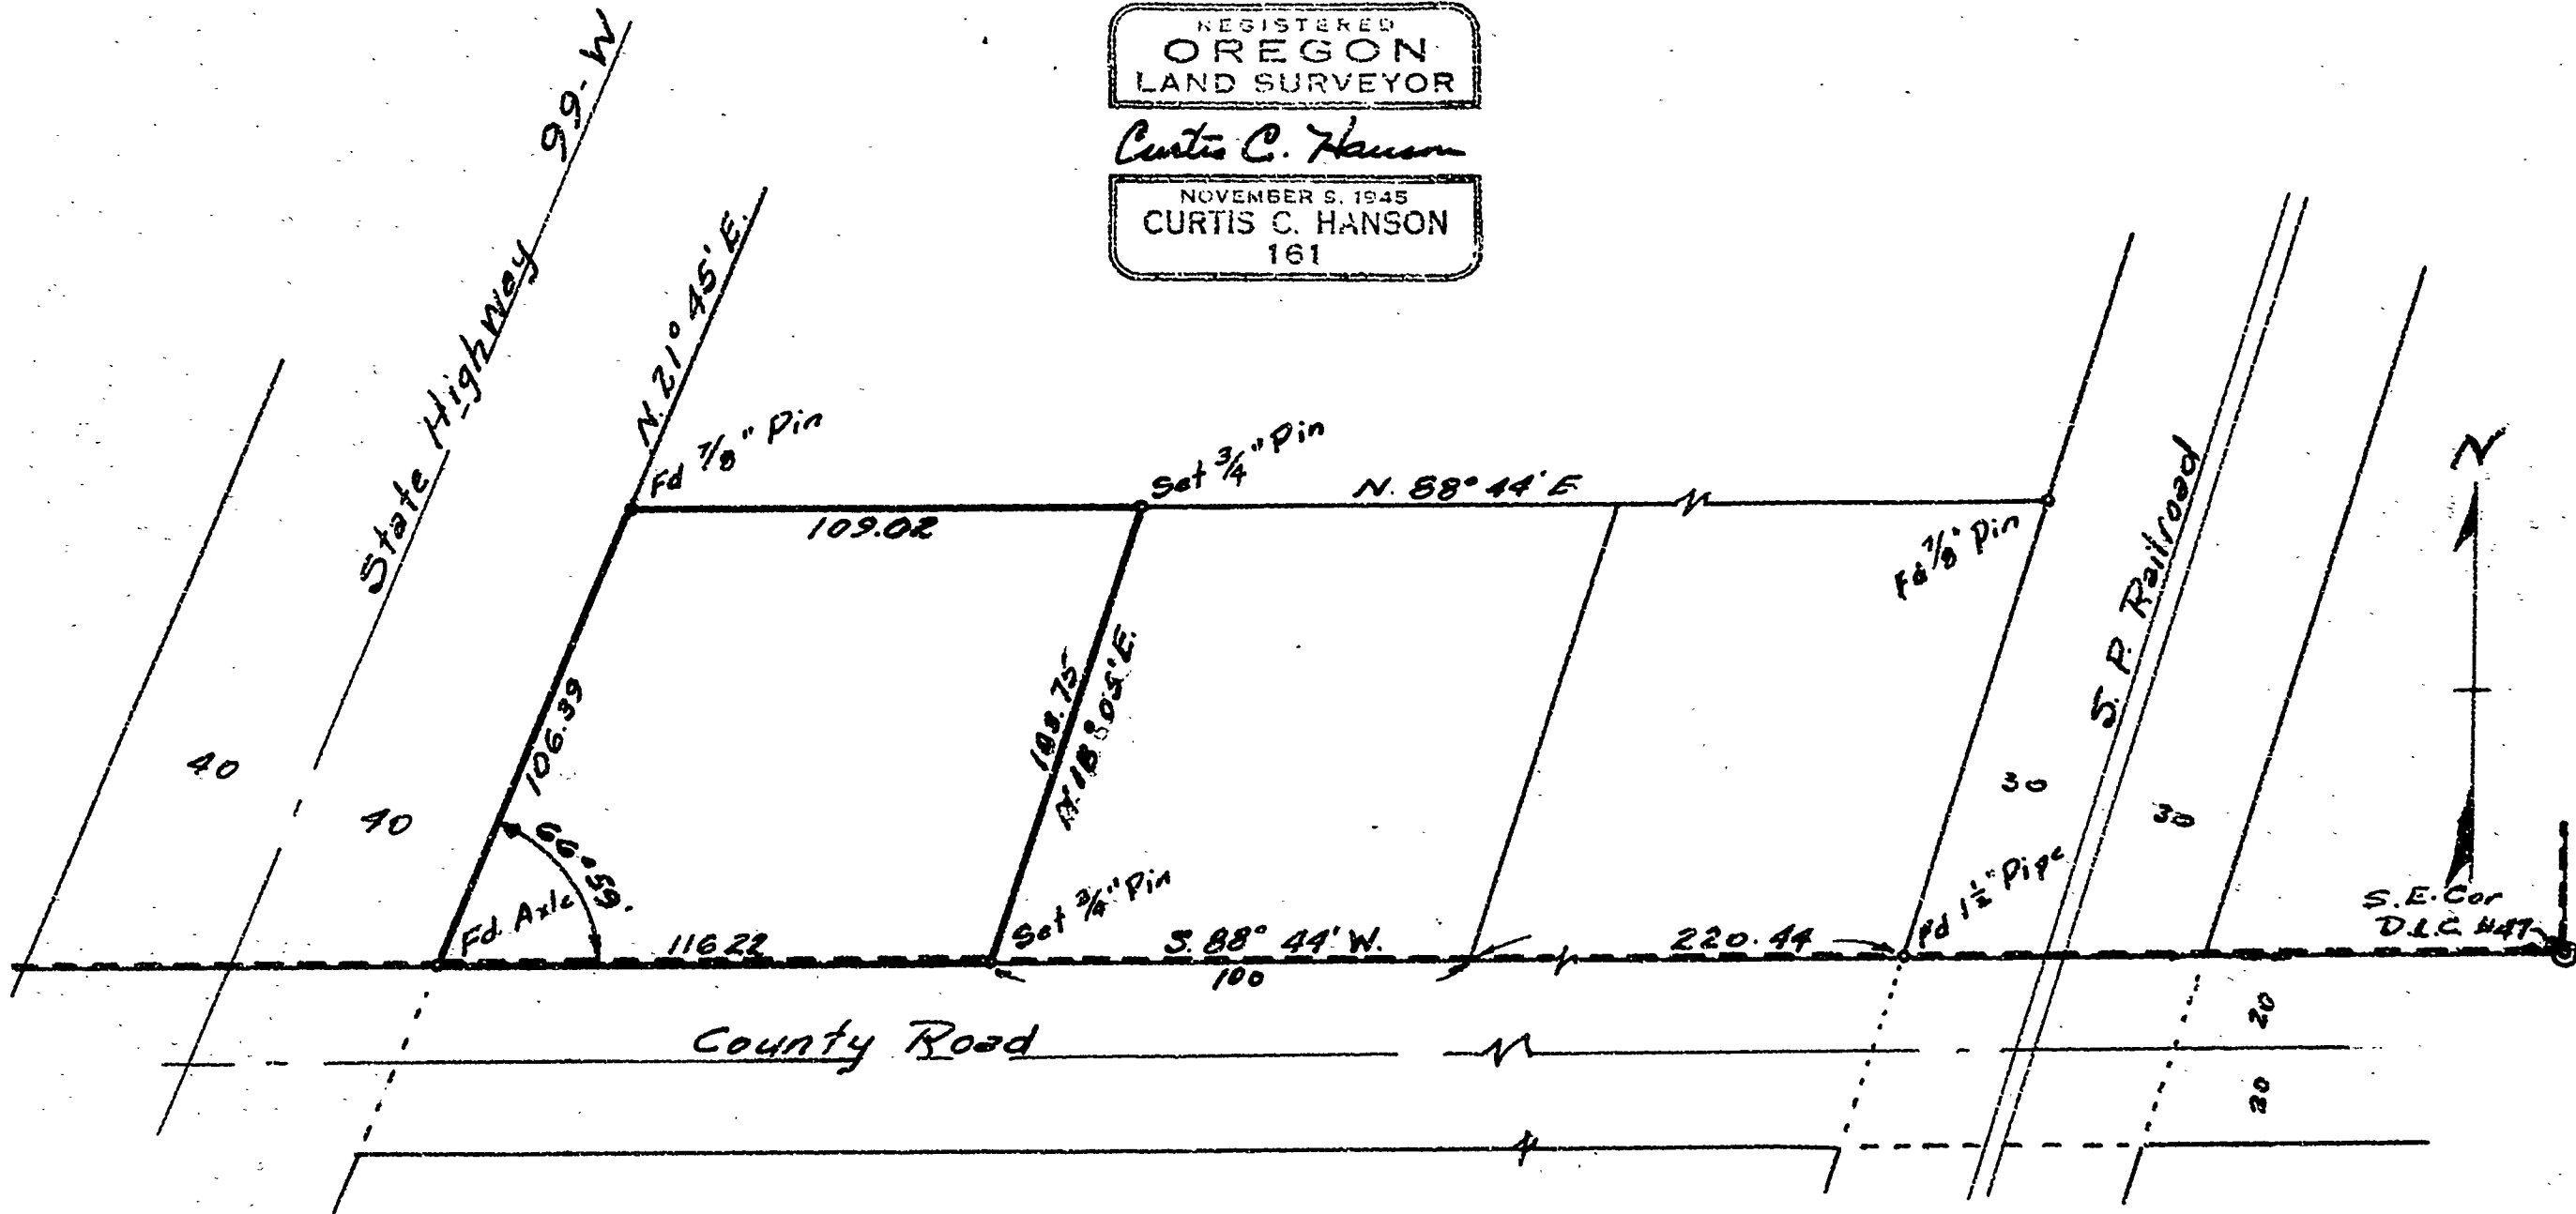

2545

FOR FLOYD SANDERS 2/5/54

H. C. LEWIS D.L.C. # 47

TILLIS, R. STAN BENSON CO ORE

