


NO.R-910

## SURVEY FOR

ALFRED AUSTIN

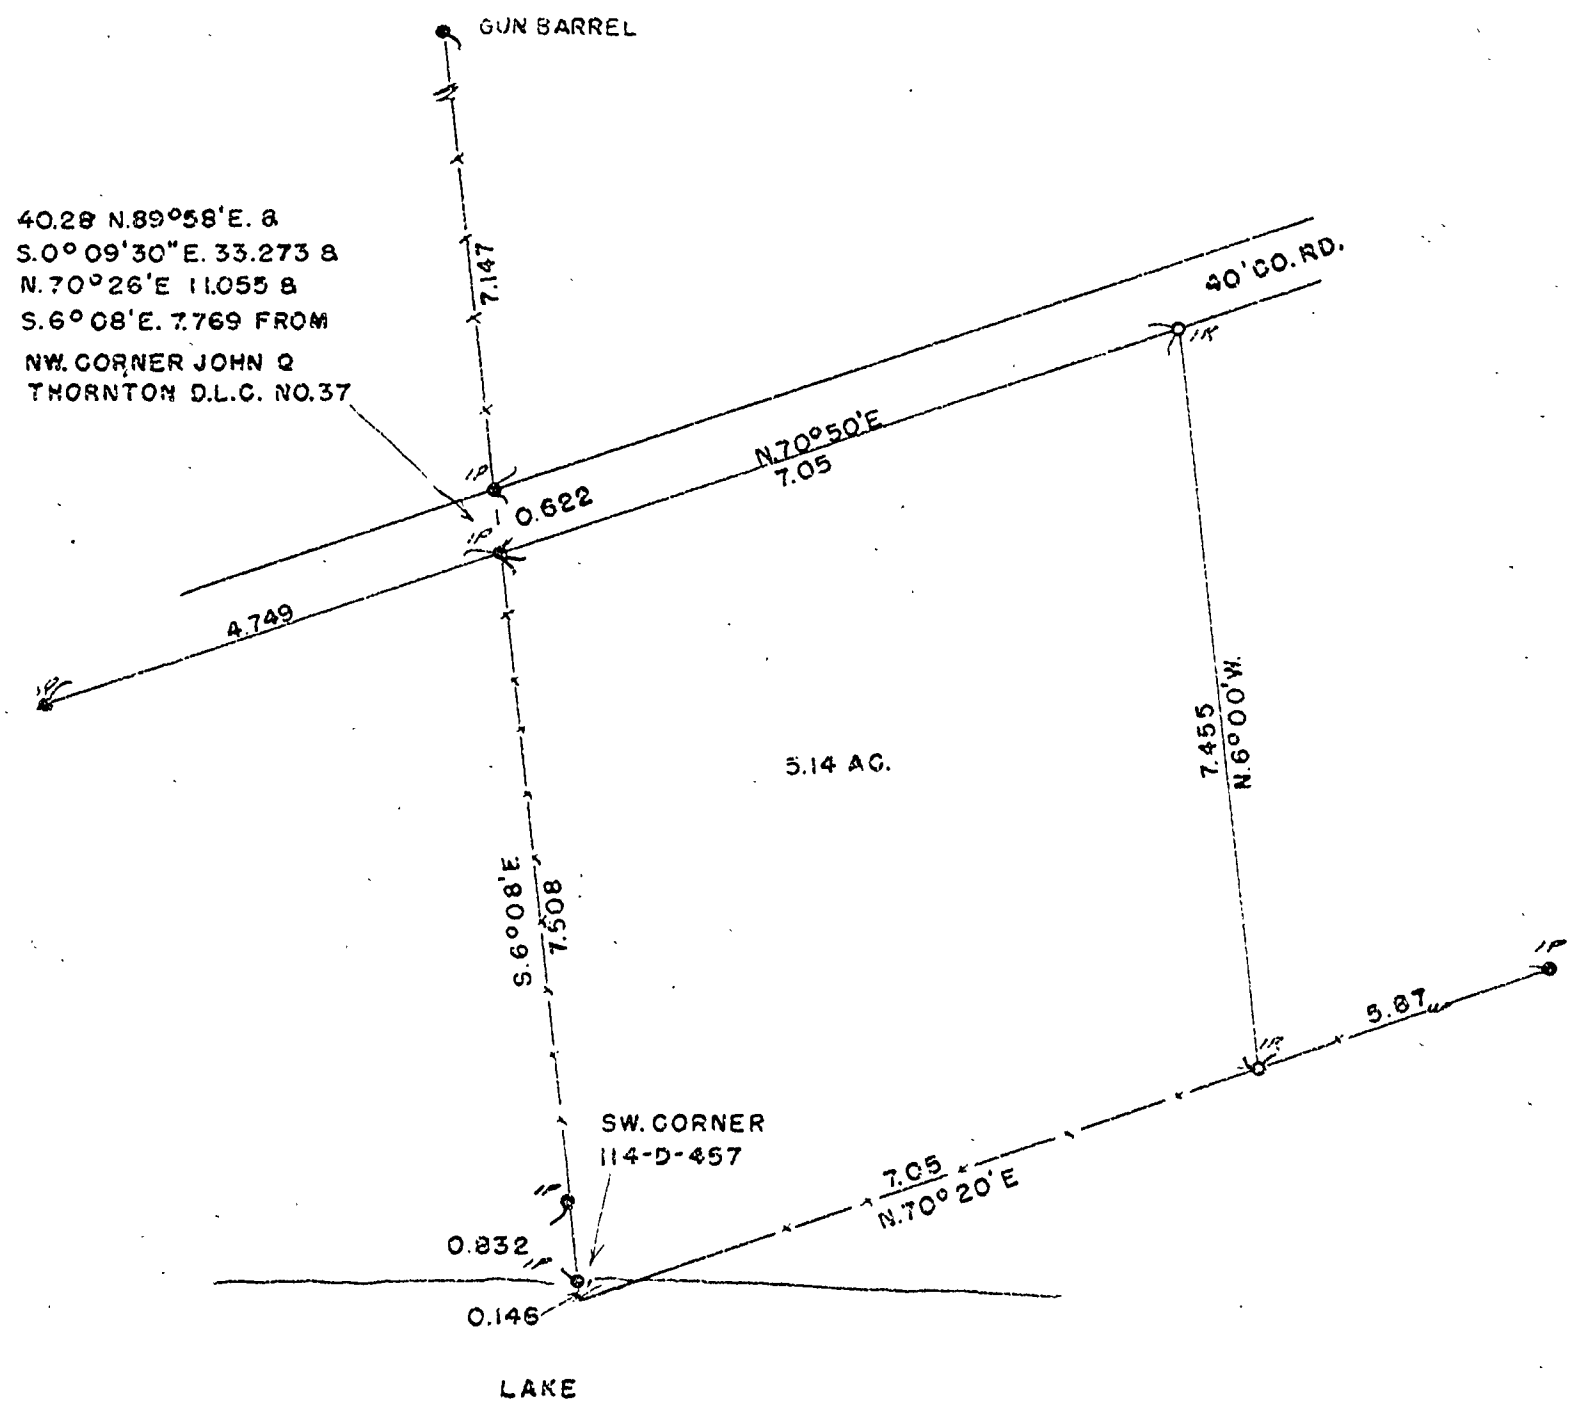

3-22-54

○ DENOTES MONUMENTS SET

● DENOTES MONUMENTS FOUND

T10 S R 4 W. WM. SEC. 36

(BEARING &amp; DIST. OF RECORD)

BENTON COUNTY  
~~MARION COUNTY~~

OREGON

*Ralph G. Barnes*

DAVID F. BATES RALPH G. BARNES  
 LAND SURVEYORS  
 SALEM, OREGON