

2593

ORVAL F. BLOSSOM
LOT 11, BLOCK 19, ORIGINAL TOWN-
OF MARYSVILLE, BENTON CO.,
OREGON.

Scale: 1" = 50 ft.

JULY 28, 1954.

REGISTERED
OREGON
LAND SURVEYOR
Curtis C. Hanson
NOVEMBER 9, 1945
CURTIS C. HANSON
161

C.S. # 2595

Bk 19 0 TM

For O.F. Blosson


Mon

Wash

ST

Clear
Hot

Yes

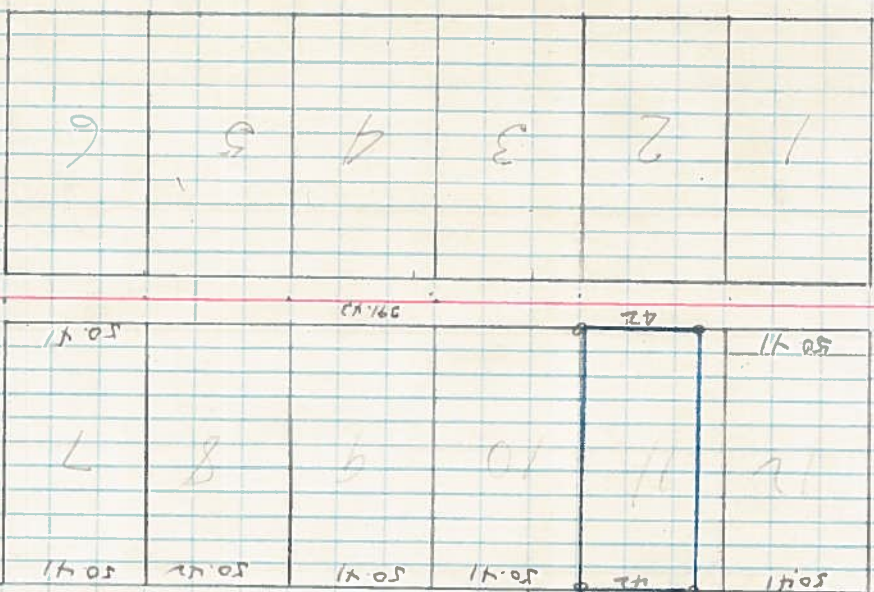

5/6 ST

5/6 ST
39/64

5/6 ST

5/6 ST