


# SURVEY FOR

J. H. FOBAR

40.28 S. 89°47'E. & 10.18 N. 89°58'E  
FROM NW. COR. JOHN Q. THORNTON  
D.L.C. NO. 37

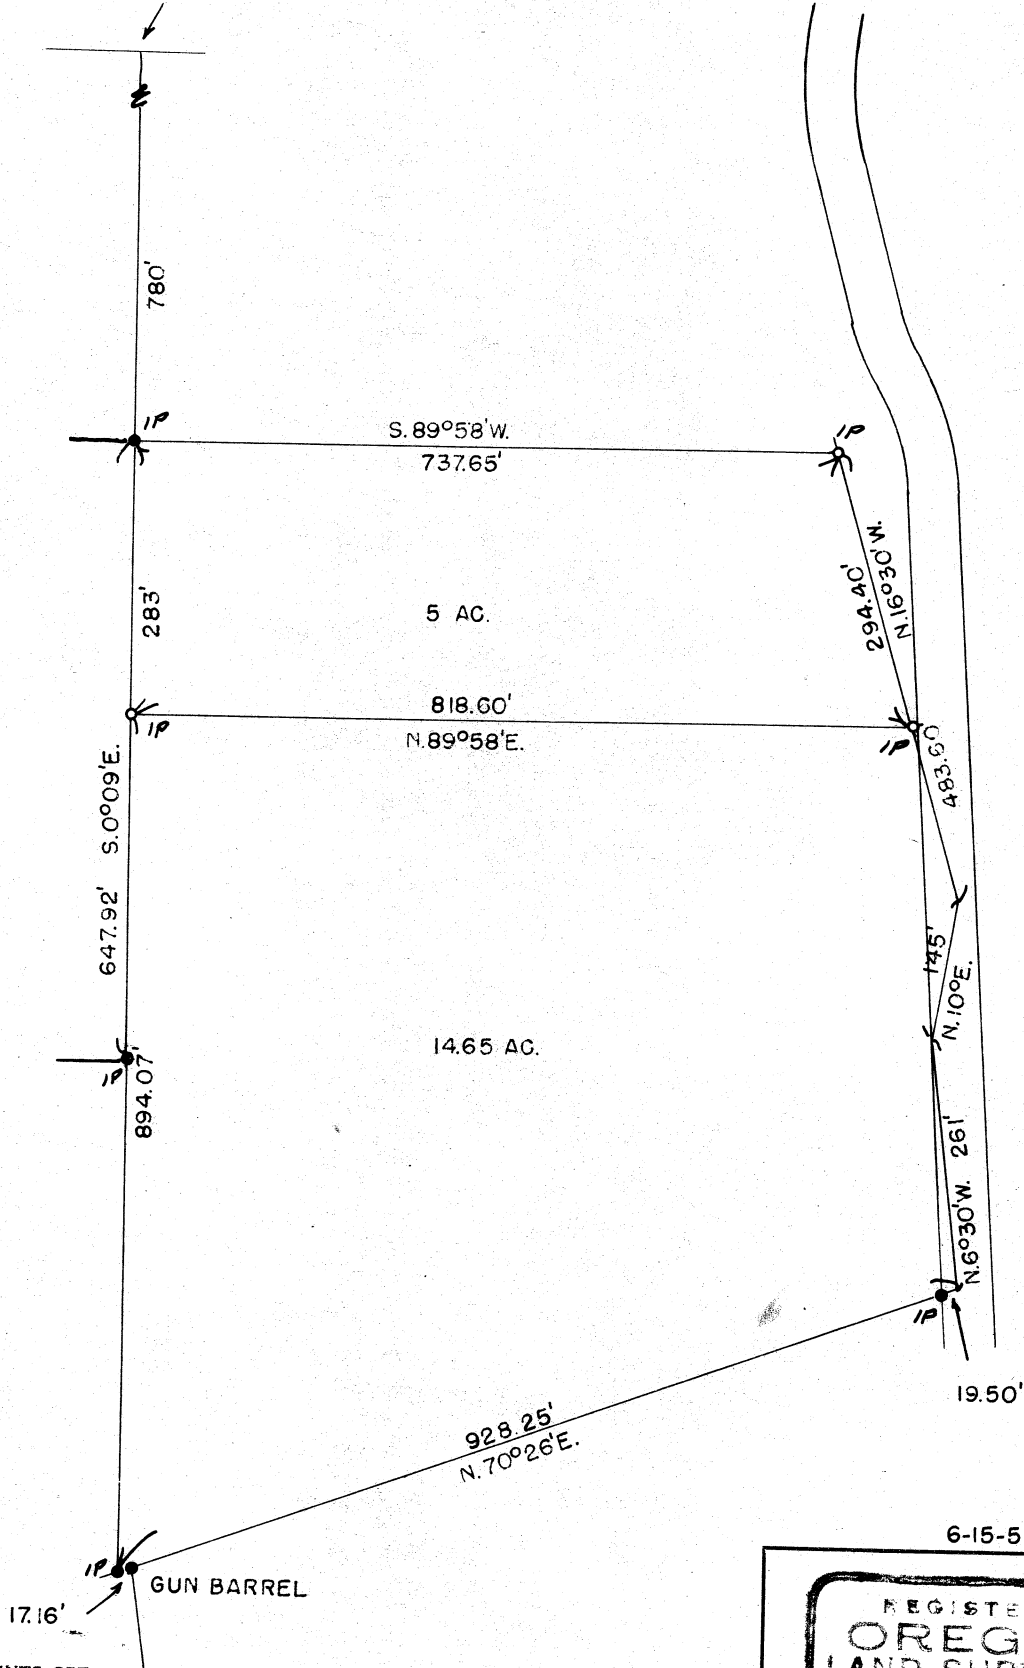

6-15-54

○ DENOTES MONUMENTS SET

● DENOTES MONUMENTS FOUND

T 10 S R 4 W. W. M SEC. 36

(BEARING & DIST. OF RECORD)

BENTON COUNTY  
MARION COUNTY  
OREGON

REGISTERED  
OREGON  
LAND SURVEYOR

*Ralph G. Barnes*  
MAY 5, 1950  
RALPH G. BARNES  
263

DAVID F. BATES RALPH G. BARNES  
LAND SURVEYORS  
SALEM, OREGON