


2606

H. G. VONSILD

SECTION 4, TWP. 12 S., R. 6 W., W.M.
SCALE: 1" = 400' APRIL 21, 1954.

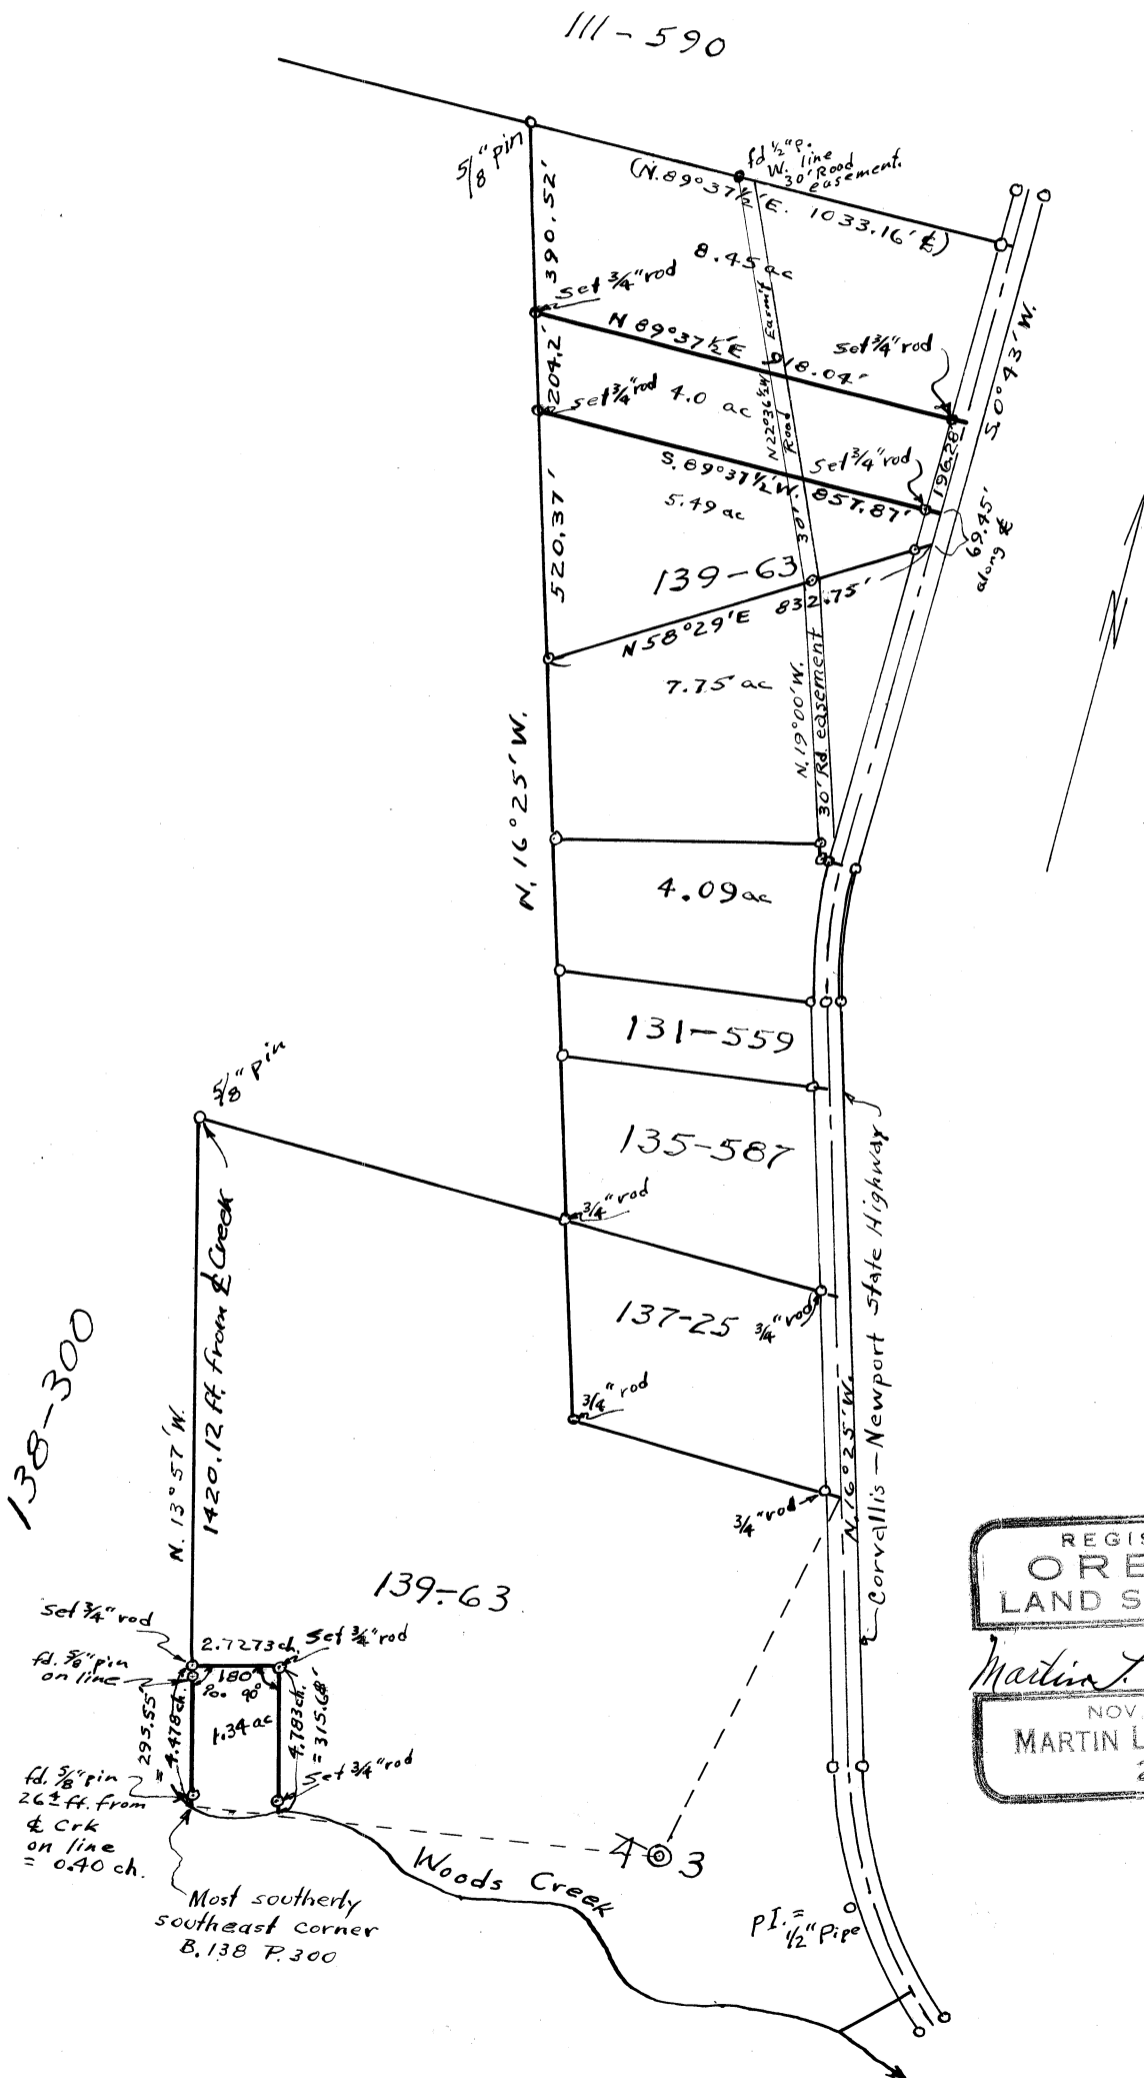

REGISTERED
OREGON
 LAND SURVEYOR

Martin L. Beyerlein
 NOV. 5, 1948
MARTIN L. BEYERLEIN
 247