

1292

2621

MERLE A. LONG


JOS. C. AVERY D.L.C. No. 41, TWP. 12 S., R. 5 W., WIL. MER.

Scale: 1" = 20'

October 3, 1954

2621

2621

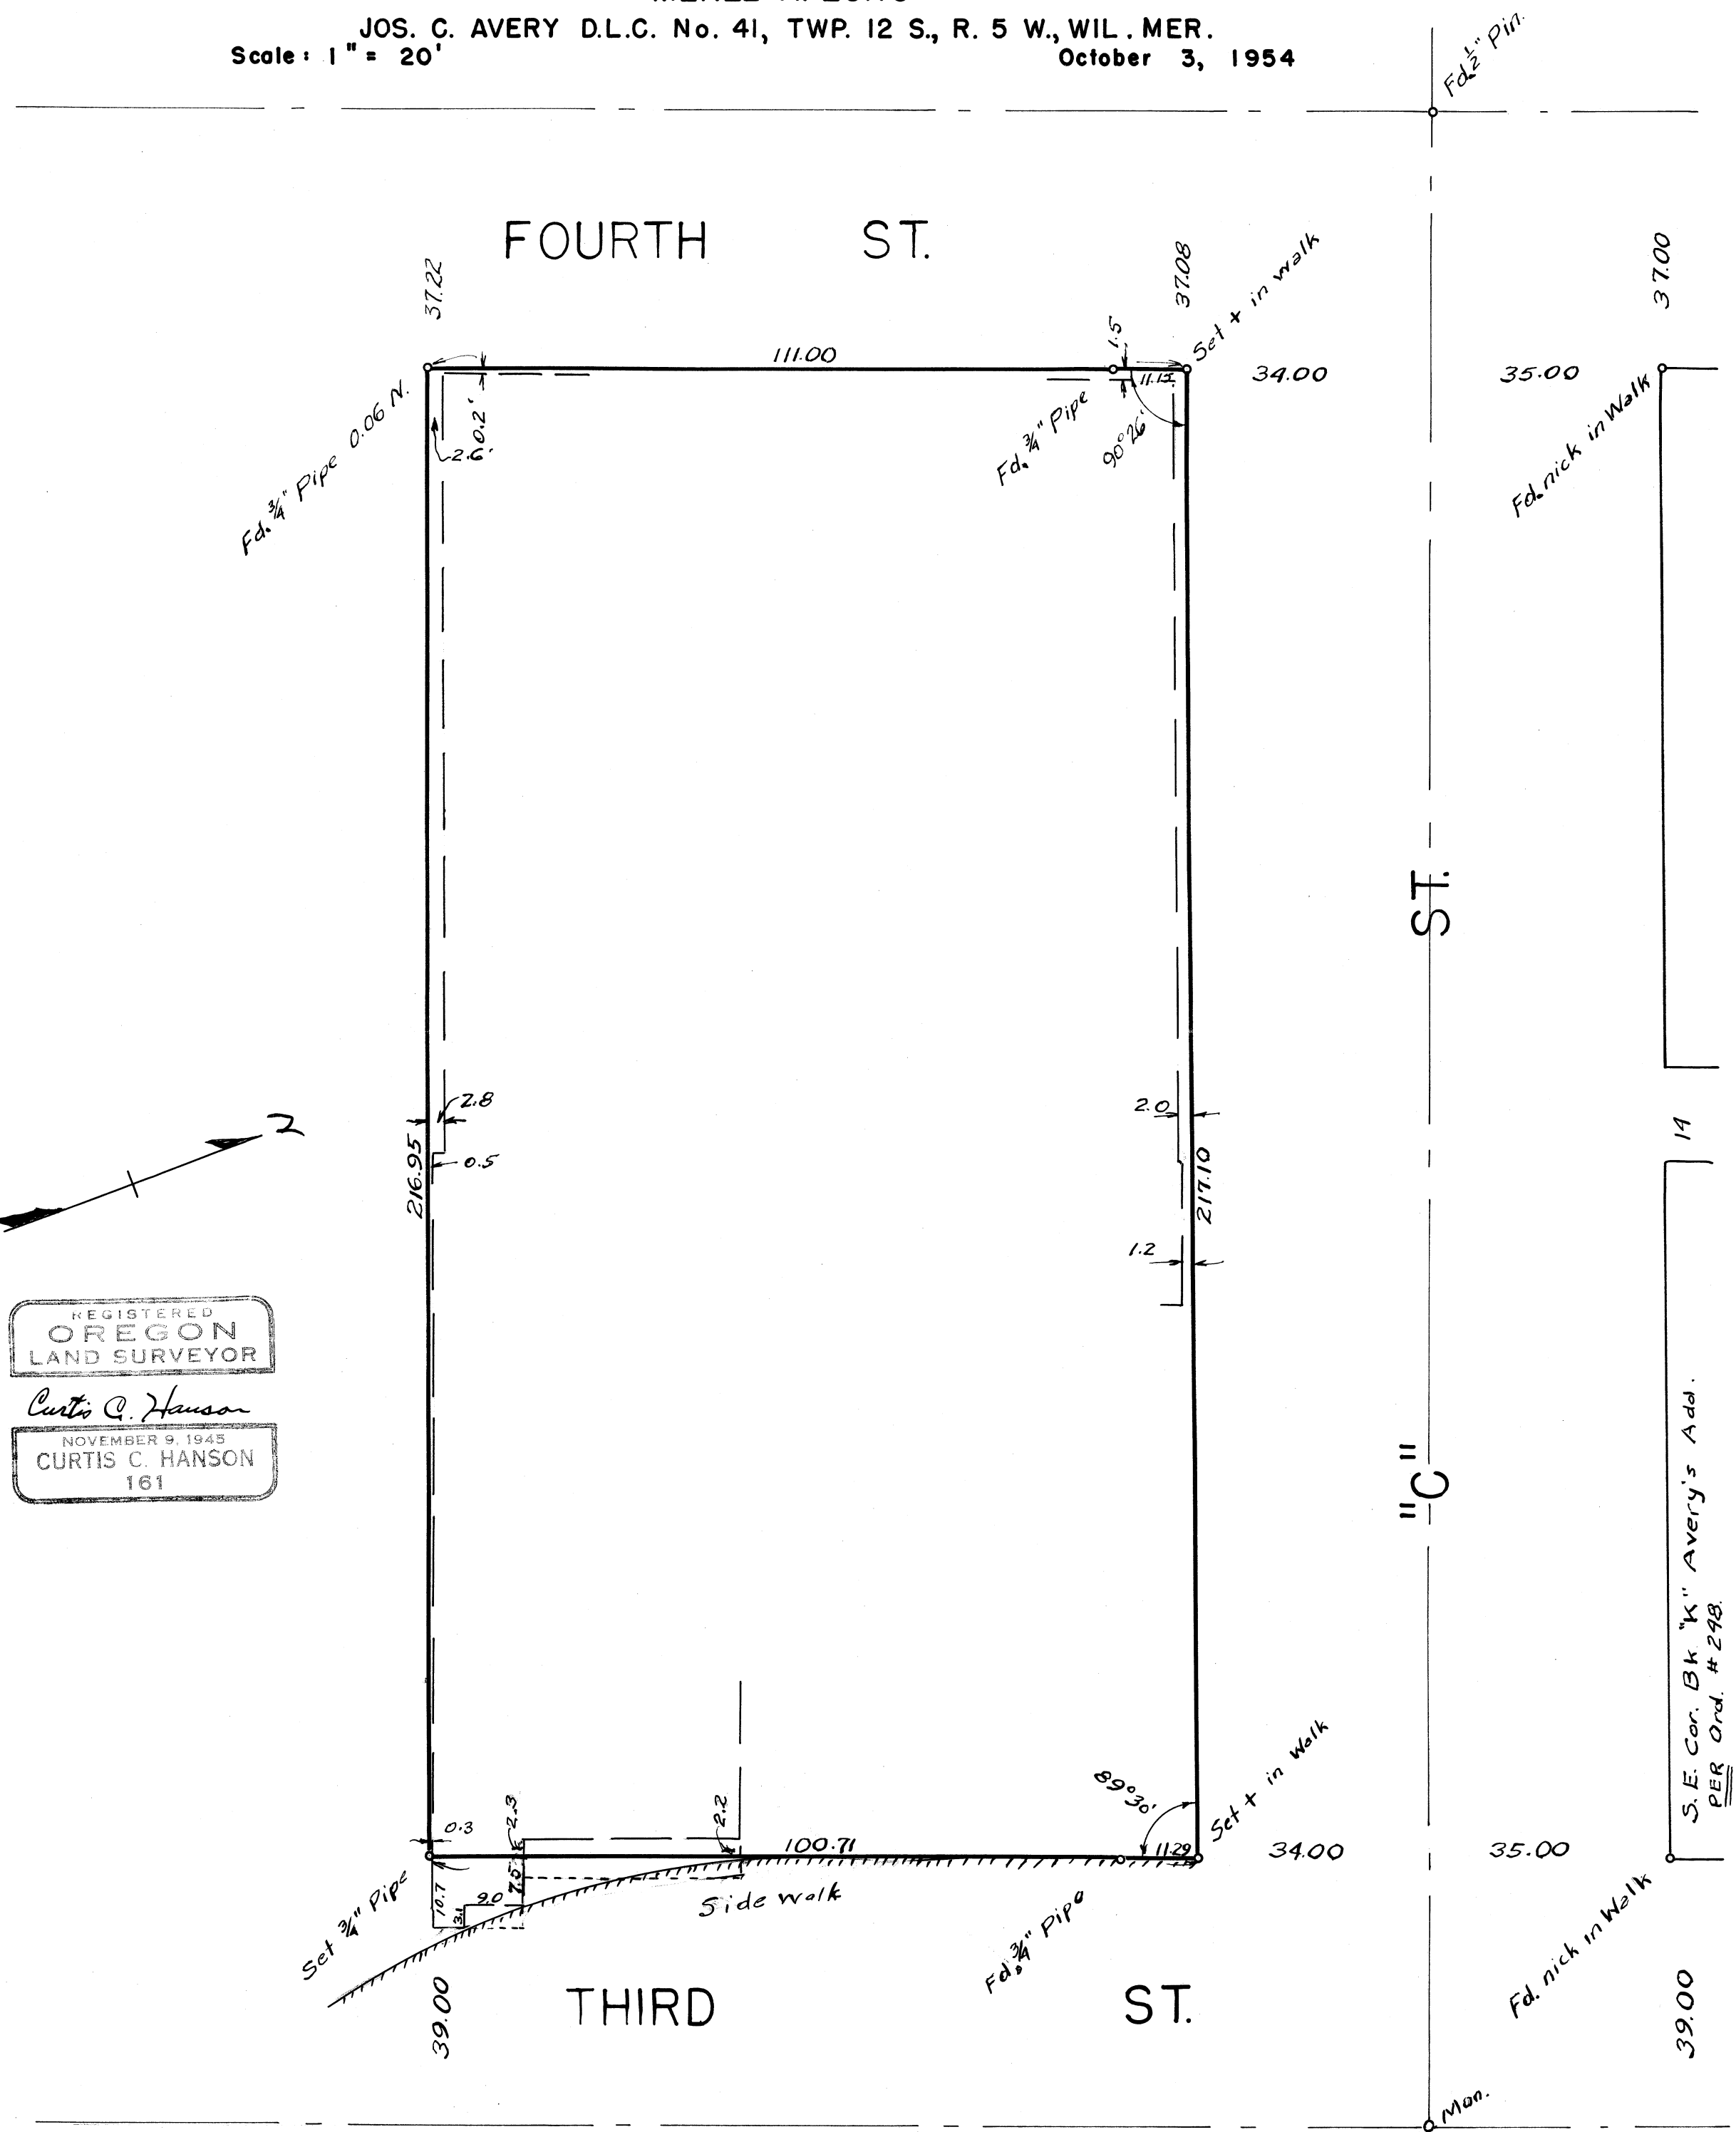

REGISTERED  
**OREGON**  
 LAND SURVEYOR  
*Curtis C. Hanson*  
 NOVEMBER 9, 1945  
**CURTIS C. HANSON**  
 161

S.E. Cor. Bk "K" Avery's Add.  
 PER Ord. # 298.

2621

CI 91-12-J

2621

9-27-54

For M. A. Long

H A  
Pickett  
Khoo ch.

