

Survey in North Albany  
for

John Guyton


1" = 4 ch

O.H.M.

Feb. 20, 1955



2656

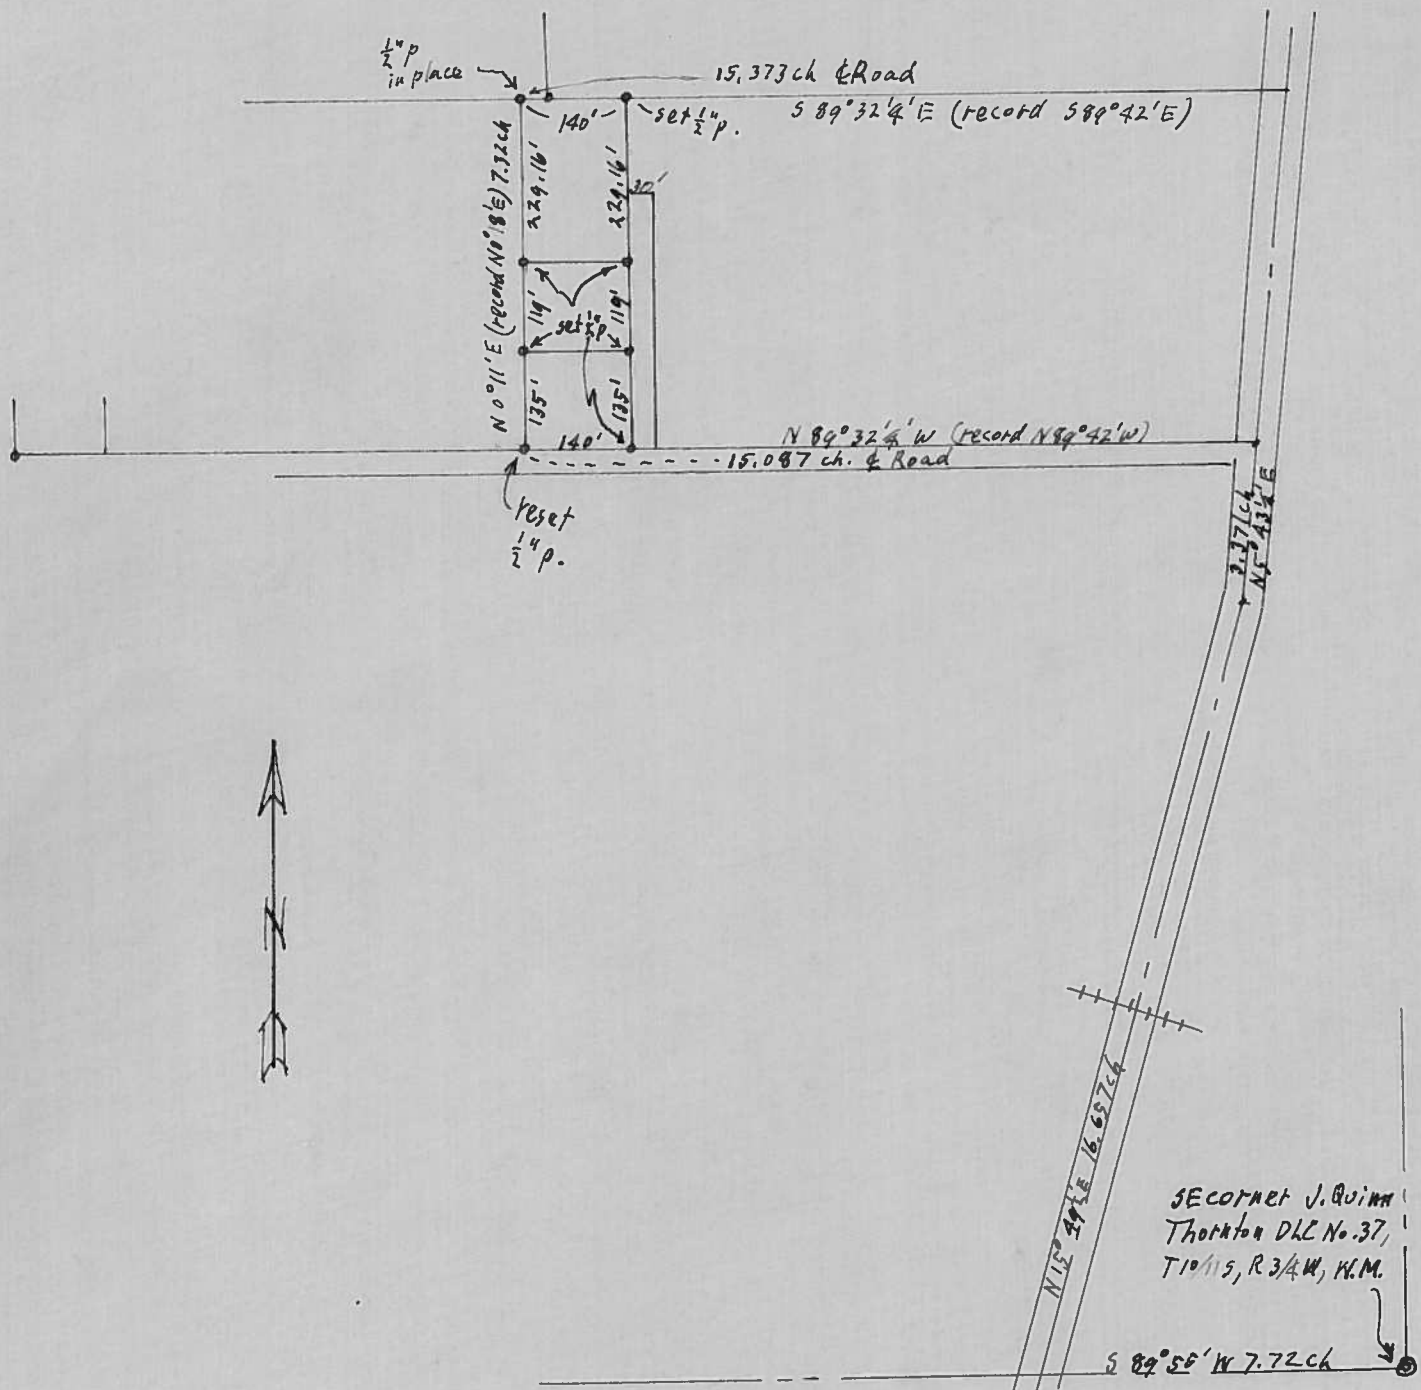

Survey in North Albany  
 for  
 John Guyton  
 $1'' = 4$  ch

O.H.M.

Feb. 20, 1955

