


2659



H. G. STEINEL

Heman C. Lewis D.L.C. No. 47, Twp. 11 S., R. 5 W., W.M.  
March 19, 1955

Scale: 1" = 100'

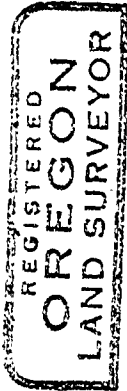

*Curtis C. Hanson*

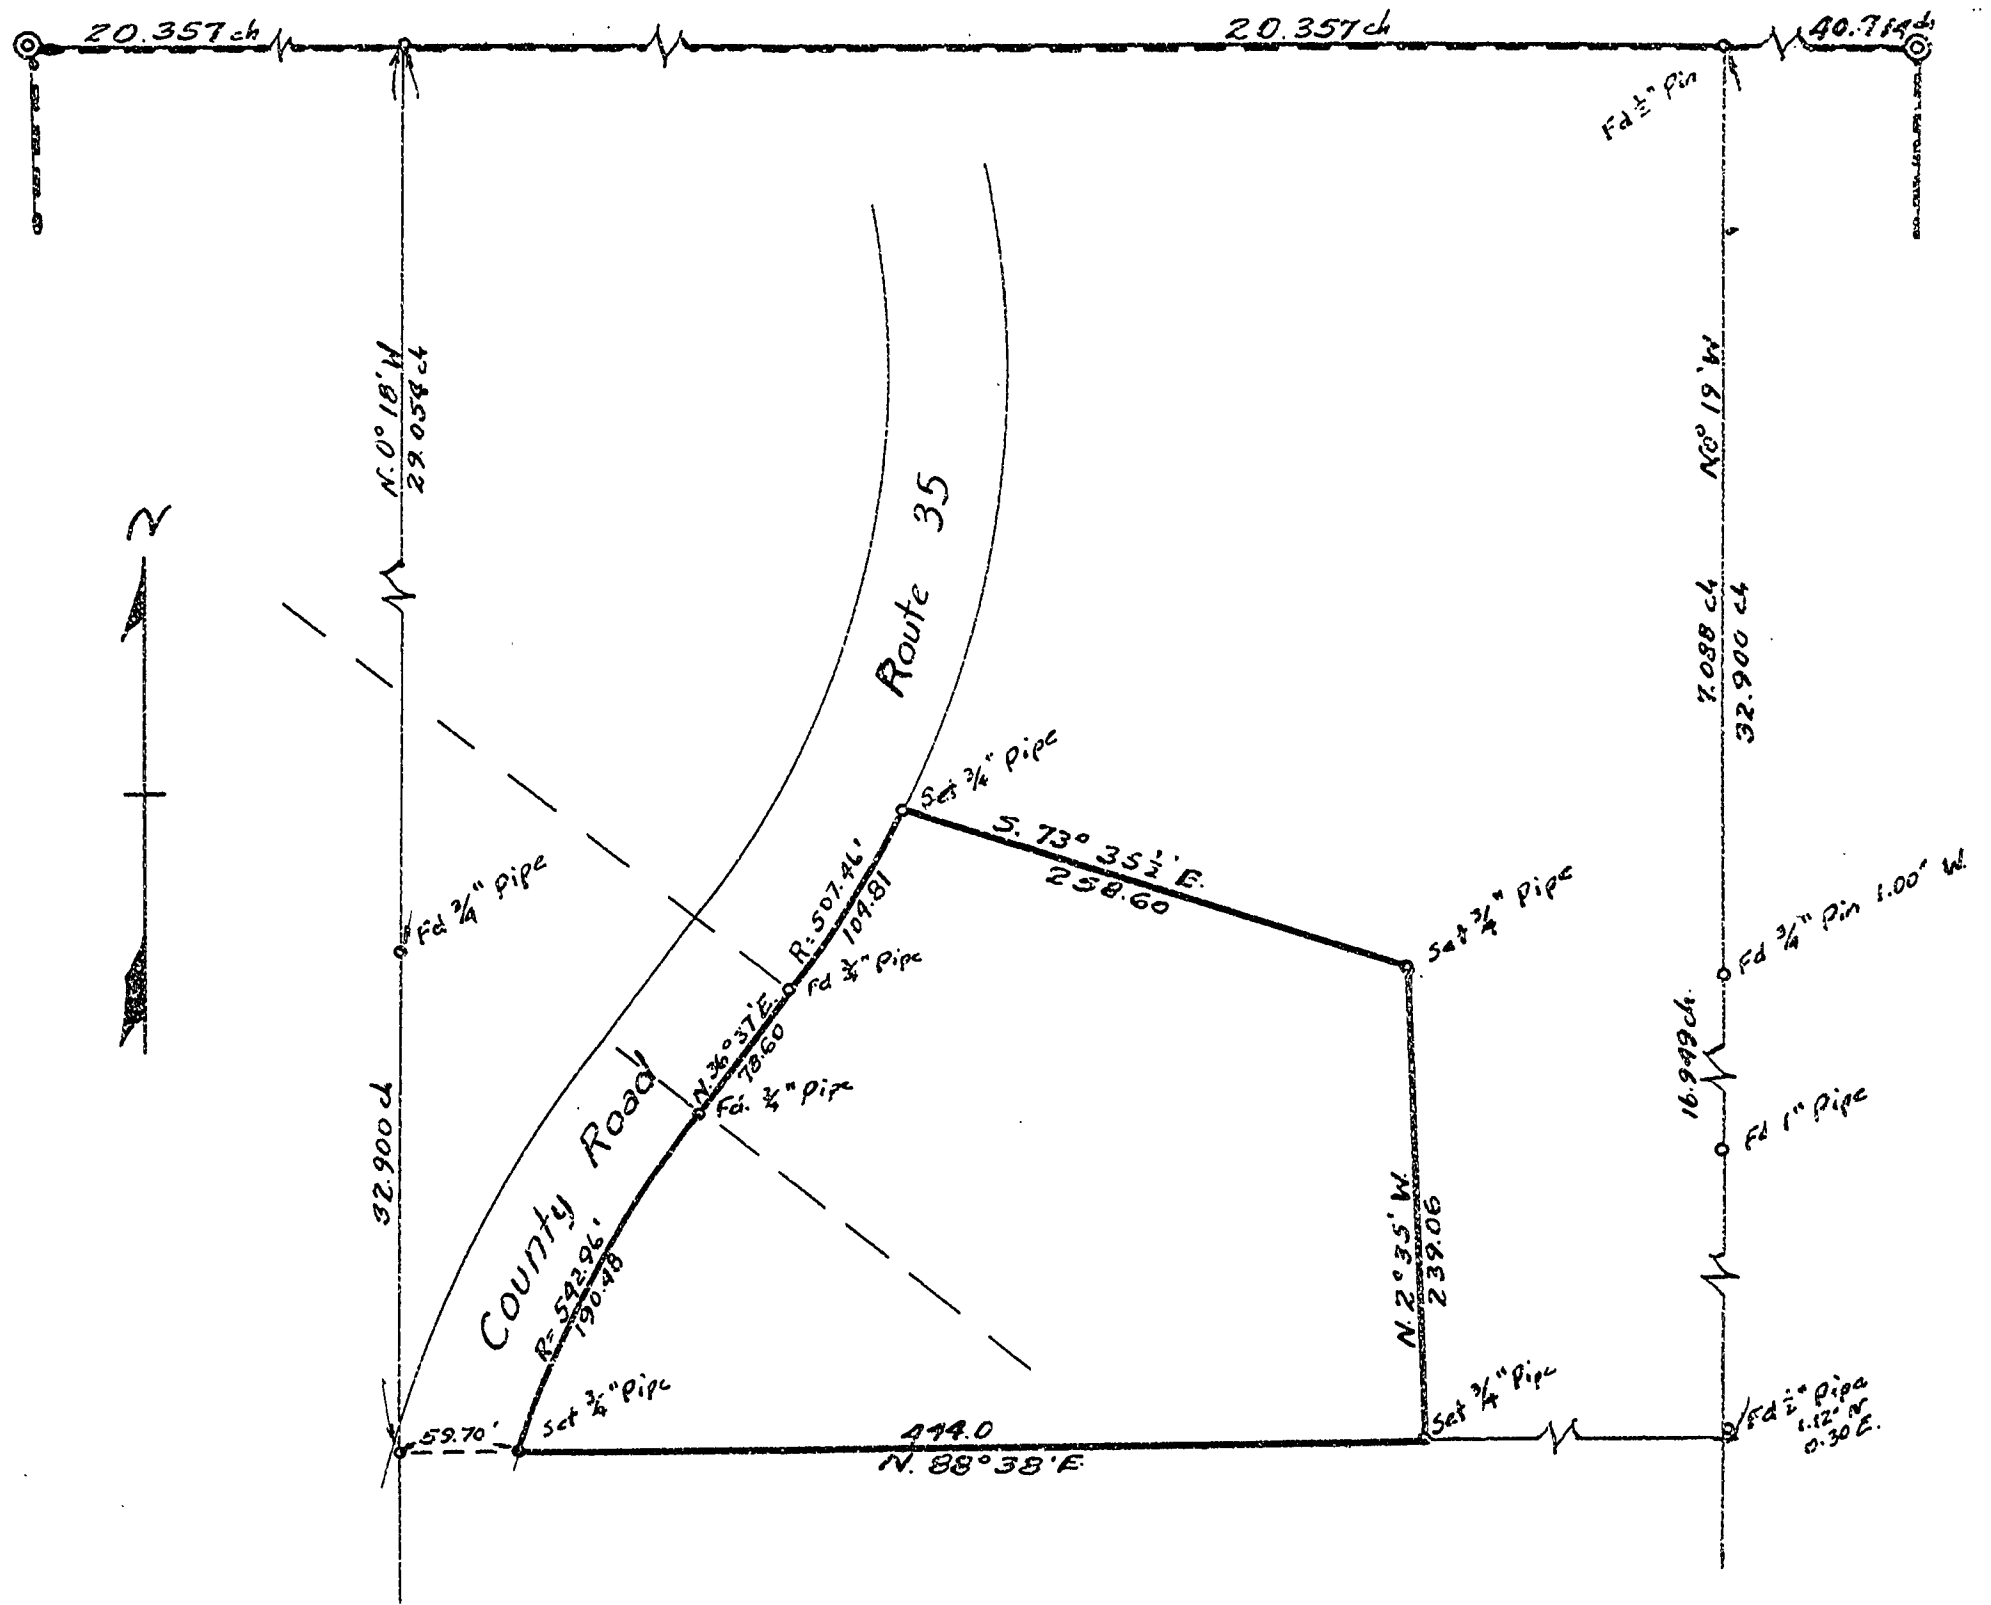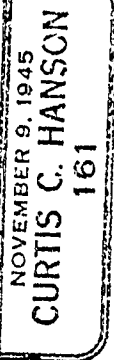



H. G. STEINEL

Heman C. Lewis D.L.C. No. 47, Twp. 11 S., R. 5 W., W.M.  
Scale: 1" = 100' March 19, 1955

REGISTERED  
OREGON  
LAND SURVEYOR

*Curtis C. Hanson*

NOVEMBER 9, 1945  
CURTIS C. HANSON  
161

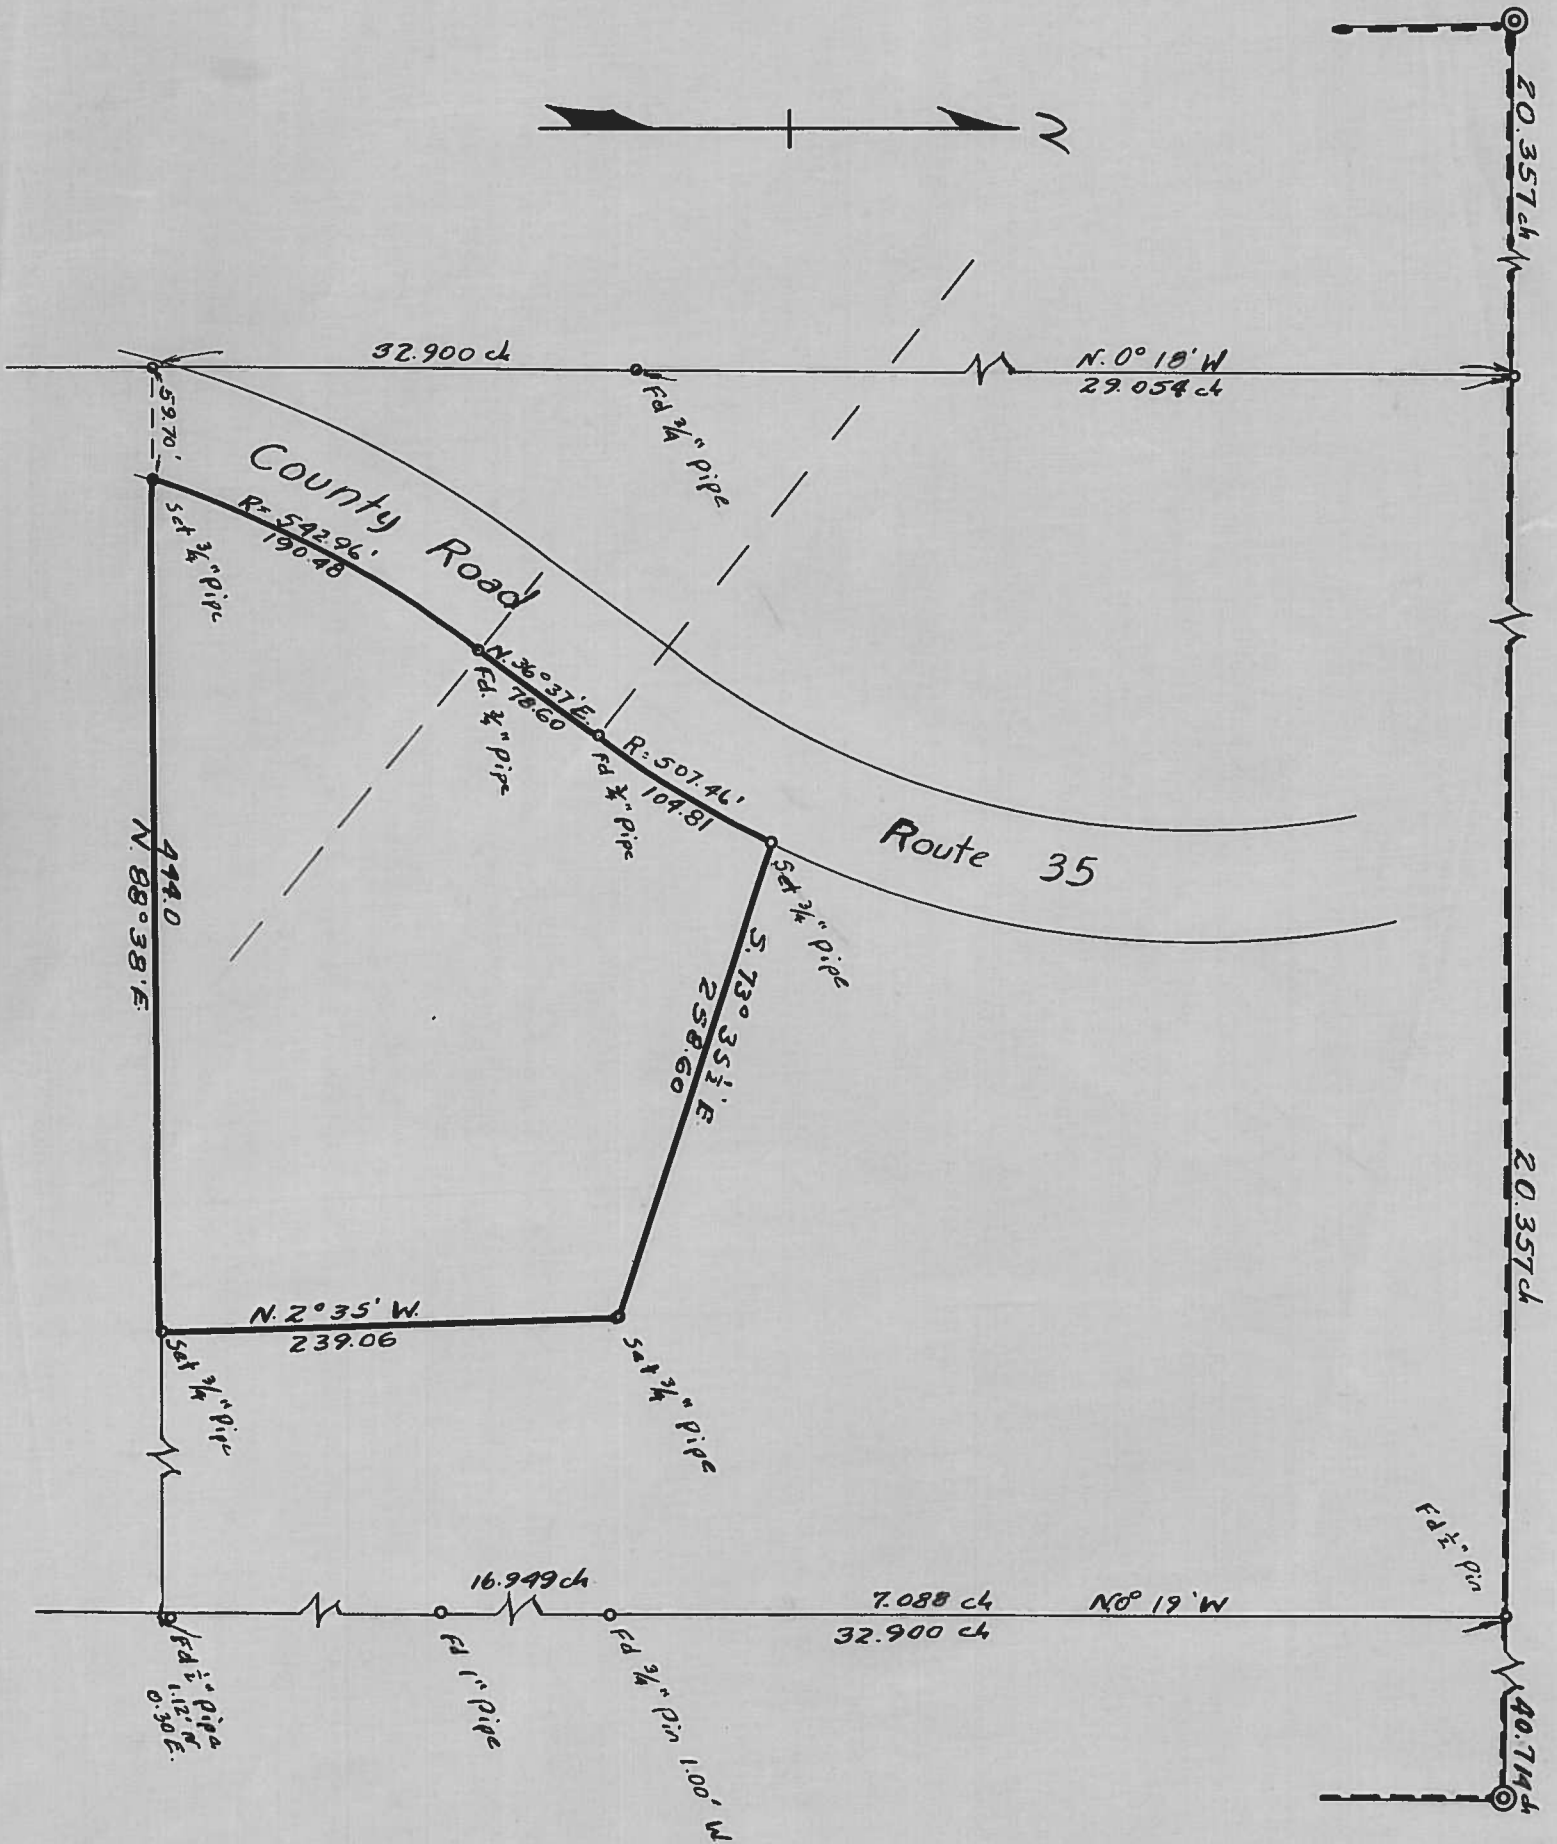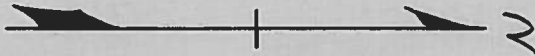

47-11-5

C.S. 10

3-7-55

Hesson At  
Walled Ch

2659

For H. G. Stencil

Set 1/4" Pipe

(R 90.58', 50°12' E  
of X Line of  
C1 97

3.816

7.957

7.765

6.533

6.540

2.040

91°19'

91°04'

138-52

14 3/4" Pipe

ch = 156.21

d = 80.16

CRcd

X Line

N 0°18' W

N 0°01' W

N 0°01' W

N

W line E/W of C17-11-5

L cor C17-11-5

3/4" Pipe

8.70

2122

010

20

2" Pipe

Initial Pt



Highland Lawn

Acres

LINE DATE \_\_\_\_\_ PARTY \_\_\_\_\_

PROJECT \_\_\_\_\_

KILHAM FORM P-172 196251

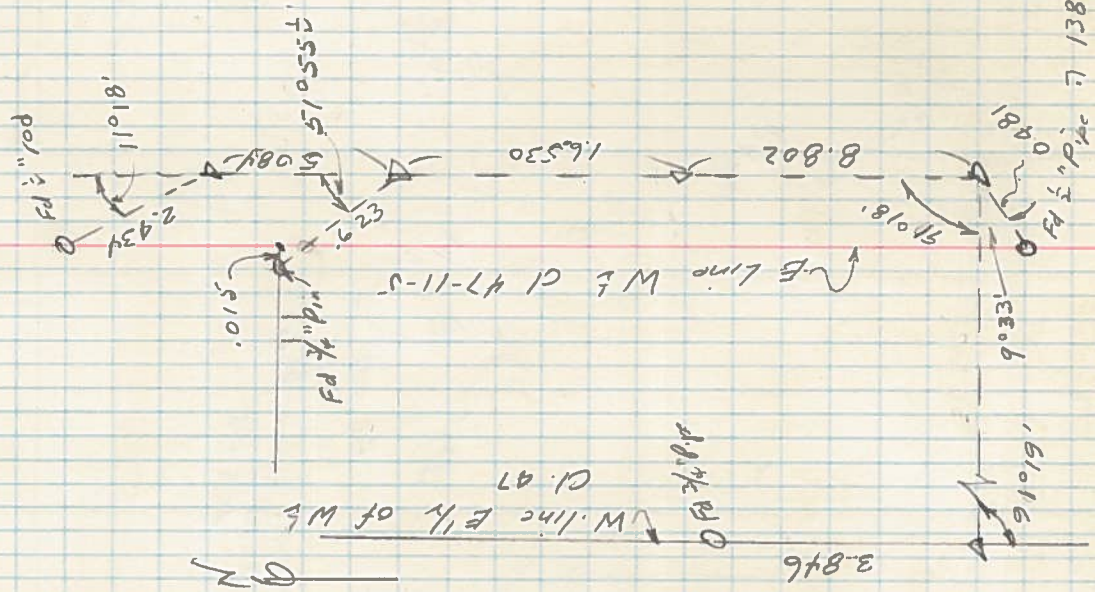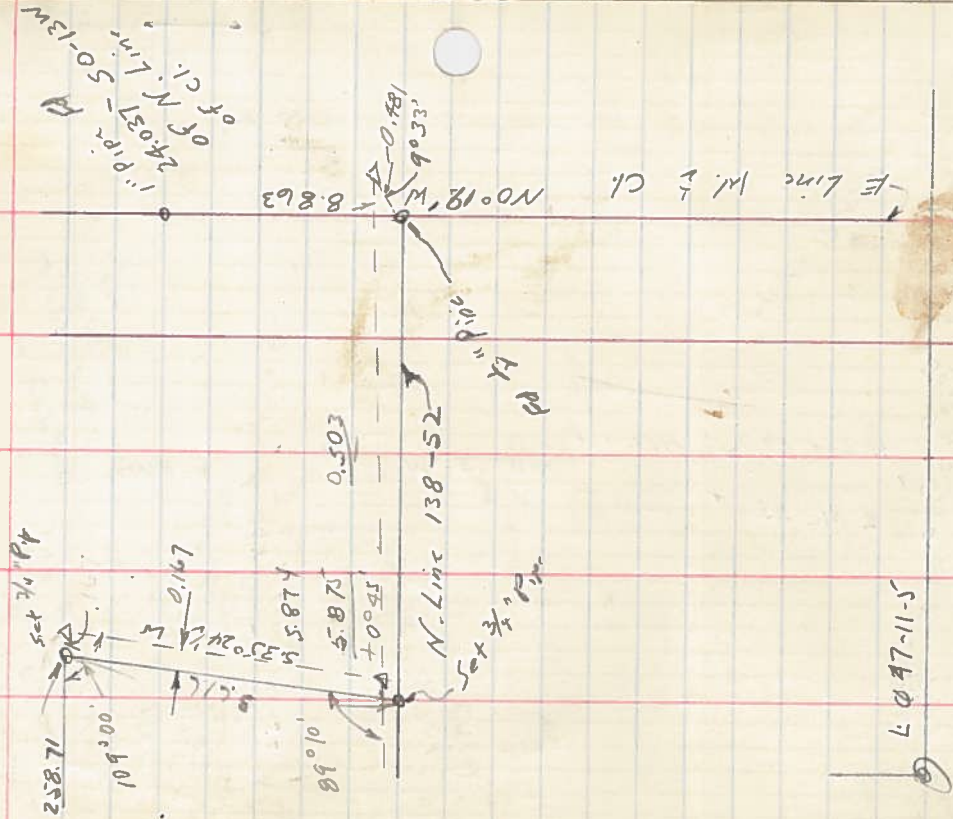

138-52



LINE DATE PARTY

PROJECT

KILHAM FORM P.172 1962E1

