

2684

SURVEY

FOR

O.H. SCHREPEL


1/4 Sec. 23, T 11 S, R 5 W, W.M.

1" = 200'

O.H.M.

July 4, 1955



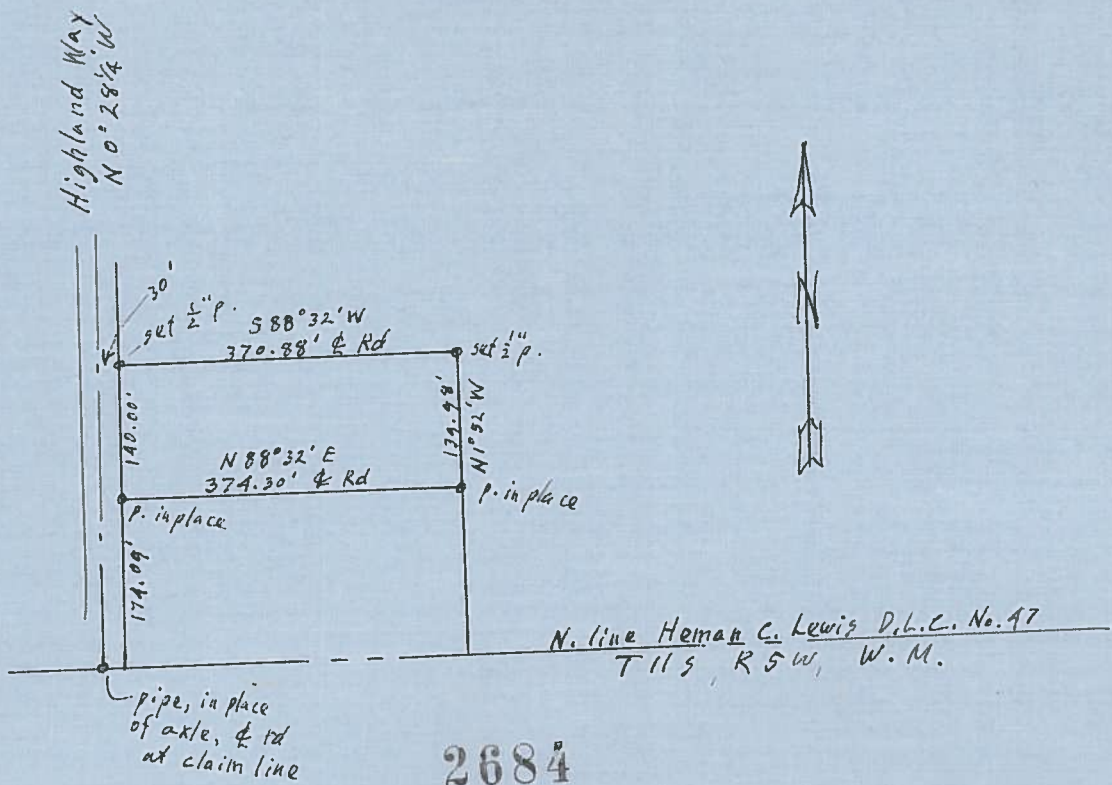

2684

SURVEY

FOR

O. H. SCHREPEL

In Sec. 23, T11S, R5W, W.M.

1" = 200'

O.H.M

July 4, 1955

