

C.S. No. 2128



ALBERT FORTIER

SECTION 31
T10S R3WWM

DEC. 1955

SCALE 1"=30'

Harold W. Pasing
Reg. Engineer

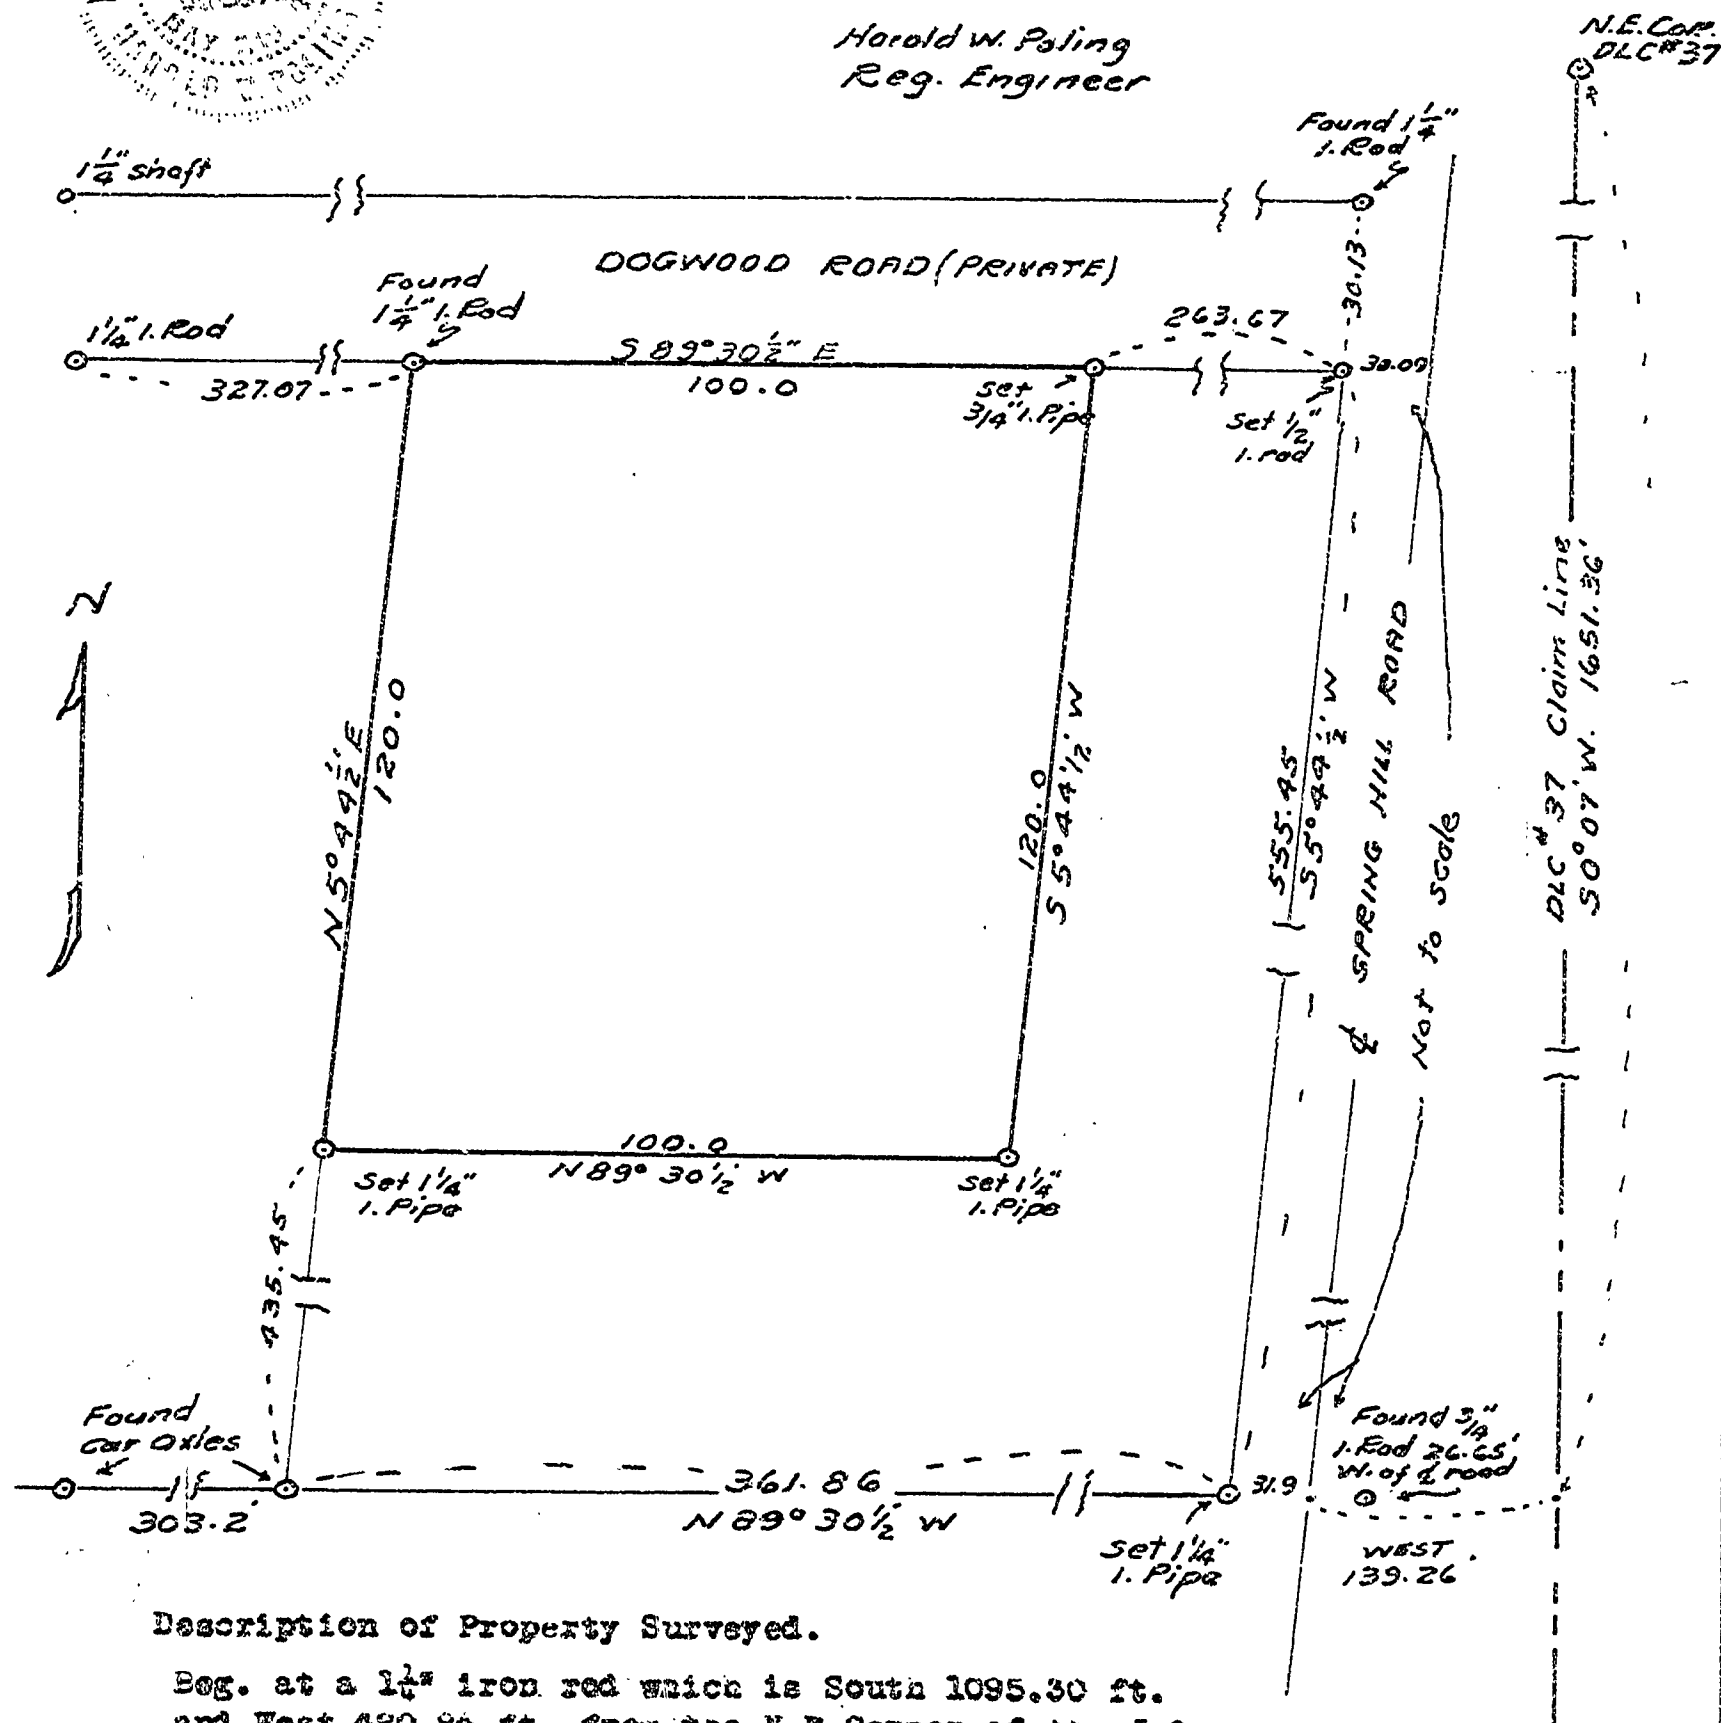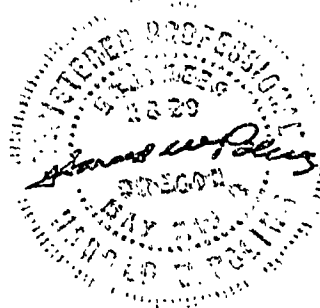

Description of Property Surveyed.

Beg. at a 1 1/4\" iron rod which is South 1095.30 ft. and West 480.84 ft. from the N.E. Corner of the J.O. Thornton D.L.C No. 37 in Section 31 T.10 S R 3 W WM Benton Co. Oregon; thence S 89 deg 30 1/2' E. 100 ft to a 3/4\" iron pipe; thence S 5 deg 44 1/2' W 120 ft. to a 1 1/4\" iron pipe; thence N 89 deg 30 1/2' W 100 ft to a 1 1/4\" iron pipe; thence N 5 deg 44 1/2' E 120 ft. to P.O.B.