


C.S. 2760

T. J. STARKER

JOHN TRAPP D.L.C. No. 56 T. 11 S., R. 5 W., W.M.  
Scale: 1" = 1/4 mi. = 1/4 ch. Apr. 12, 1956

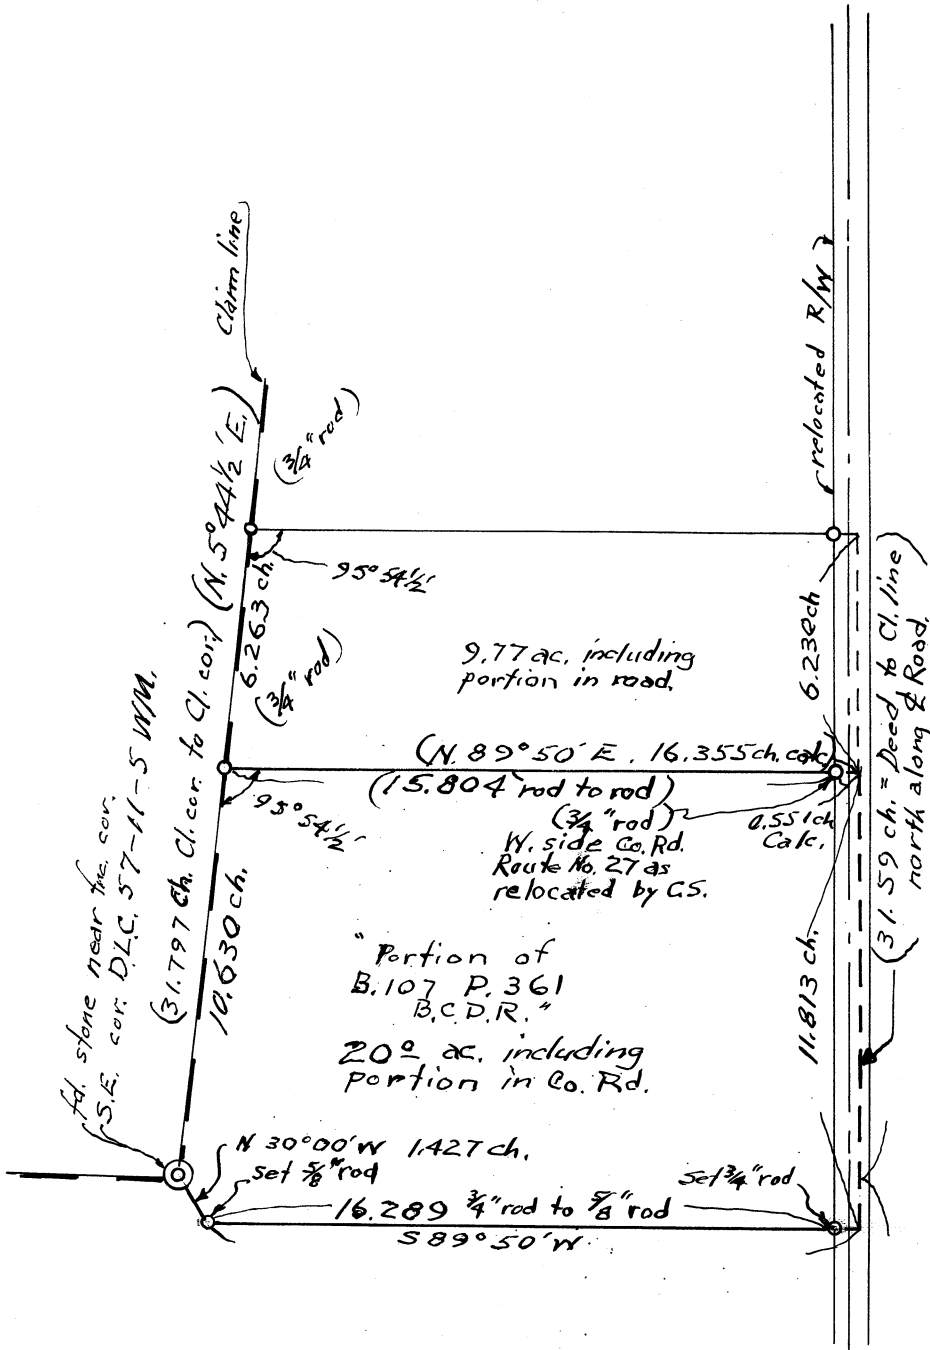

John Trapp  
D.L.C. 56-11-5 W.M.



REGISTERED  
OREGON  
LAND SURVEYOR

Martin L. Beyerlein

NOV. 5, 1948  
MARTIN L. BEYERLEIN  
247