


George Green
 Part of blk. 5, Cedar Hurst, Benton Co., Ore.
 Scale 1"=60'

July 31, 56

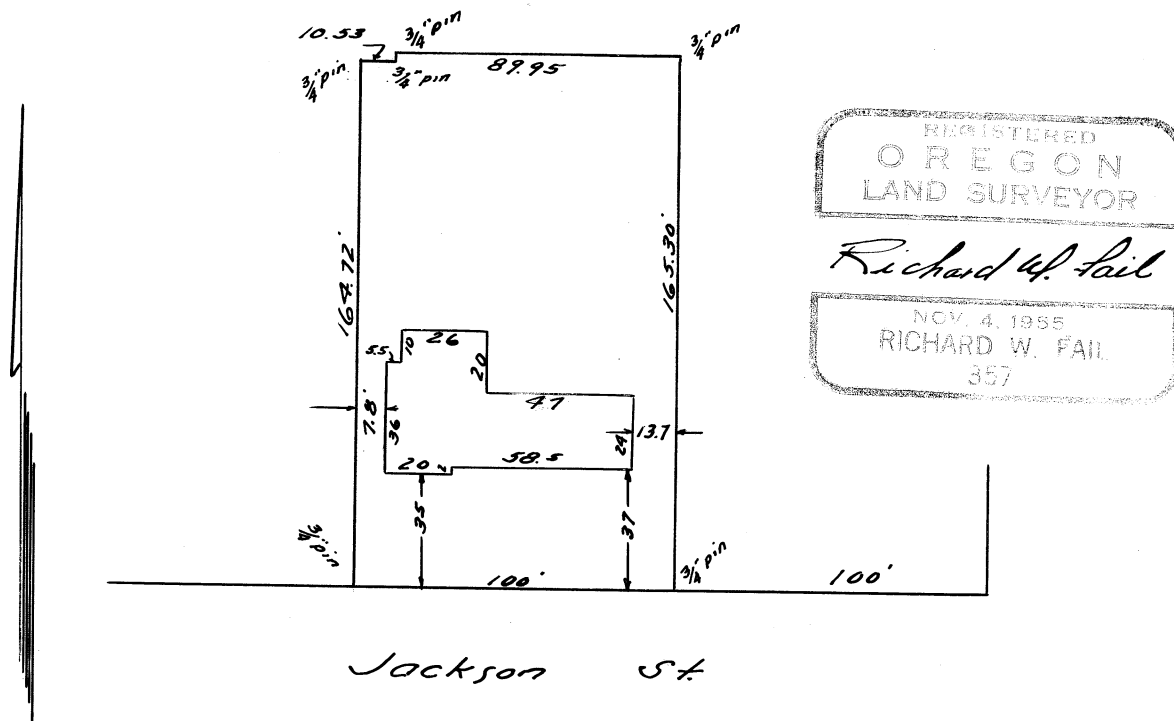

Beginning on the South line of blk. 5, 100 ft. westerly from the S.E. corner thereof, thence northerly, parallel to the east line of said blk., 165.3 ft. to the south line of the tract described in deed recorded in Book 137, Page 464, Benton Co. Deed Records; thence westerly, along said south line of said tract, 89.95 to a $\frac{3}{4}$ " iron pin on east line of the tract described in deed recorded in Book 132, Page 142, said Deed Records, thence along the lines of said latter tract, southerly 0.50 ft. and westerly 10.53 ft. to a $\frac{3}{4}$ " iron pin at the northeast corner of the tract described in deed recorded in Book 143, Page 557, said Deed Records, thence southerly along the east line of last mentioned tract, 167.72 ft. to the south line of said blk., thence easterly 100 ft. to the point of beginning.

I hereby certify that I find the improvements made on above described property to be on the property in question and that they do not overlap or encroach on the property lying adjacent thereto. I further certify that walls and projections of buildings on adjacent property do not encroach upon the property described herein.

The above map shows a true and correct relation of the building to the property lines and street.

The street number is 3729 Jackson St.