


N.W. CORNER OF THE T.M. READ
D.L.C. # 57 BENTON CO. ORE.

CORNER ESTABLISHED
3/4" PIPE W/BRASS CAP

N 89° 25' 27" E
320.95'

N 89° 25' 27" E 916.1'

FOUND 1 1/2" I.P.

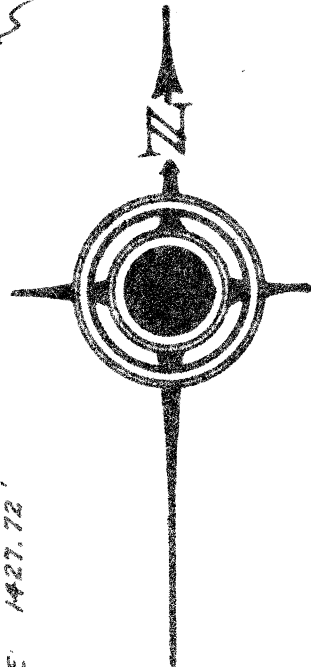

1125.79' S 1° 23' 48" E

10 ACRES
OREGON FOREST NURSERY

N 1° 23' 48" W 1425.0'

30 ACRE ACQUISITION
EAST ADDITION
NURSERY NO. 1

S 1° 23' 48" E 1427.72'

36-31
S 25° 56' 30" E
391.52'

175.91'

S 89° 35' 38" W

916.1'

CORNER ESTABLISHED
3/4" PIPE W/BRASS CAP

FOUND MONUMENT
3/4" PIPE W/BRASS
CAP FOR 1/4 COR.

EAST ADDITION NURSERY NO. 1

OREGON FOREST NURSERY

SEC. 31 T10S. R. 4 W.

SCALE 1" = 200'

BENTON COUNTY, OREGON

TRANSIT & CHAIN SURVEY: L.A., R.B., W.D., C.L.
3-18-54 DRAWN: R.S.

C.S. 282.1