


C.S. 2844

Clarence White Agency Lot 12 BIK 4 Gathercoal Addition Corvallis Oregon

Scale 1" = 20'
Nov. 16 1956

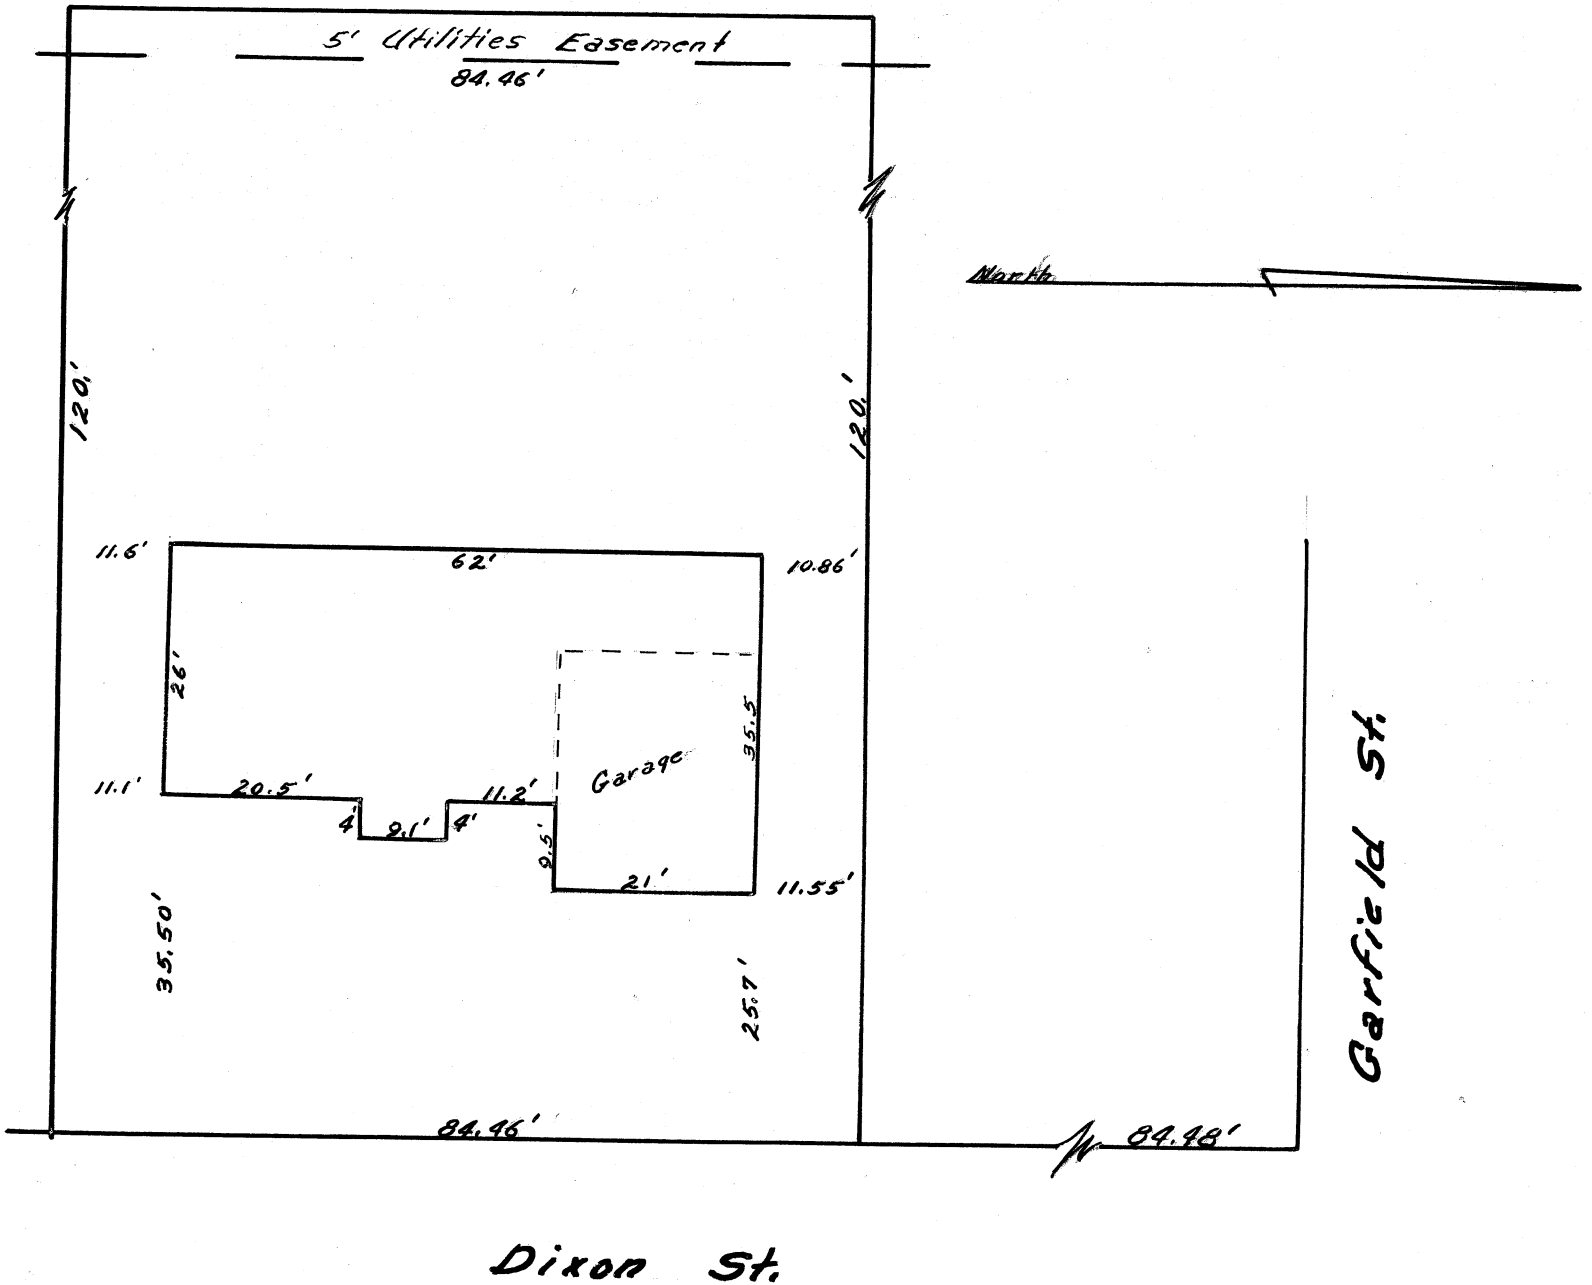

I hereby certify that I have surveyed the herein described property and that I find the improvements set thereon to be on the premises in question and that they do not overlap or encroach on the property lying adjacent thereto. I further certify that the walls and projections of buildings on adjacent property do not encroach upon the property described herein. The attached map shows a true and correct relation of the building to the property lines and streets. The street number of the property surveyed is as follows:

I have checked the building restrictions applicable to this property and find there is no violation of the set back line.

REGISTERED
OREGON
LAND SURVEYOR

J. W. Hanna
NOV. 6, 1953
J. W. HANNA
306