


T12 R6 Section 12  
Ass Map 12 BC

0.5.2865  
Walter Vincent & Sherman Morgan  
Survey in Lots 11 & 12 B1K.6  
City of Philomath Oregon  
Scale 1" = 50' 1-7-57

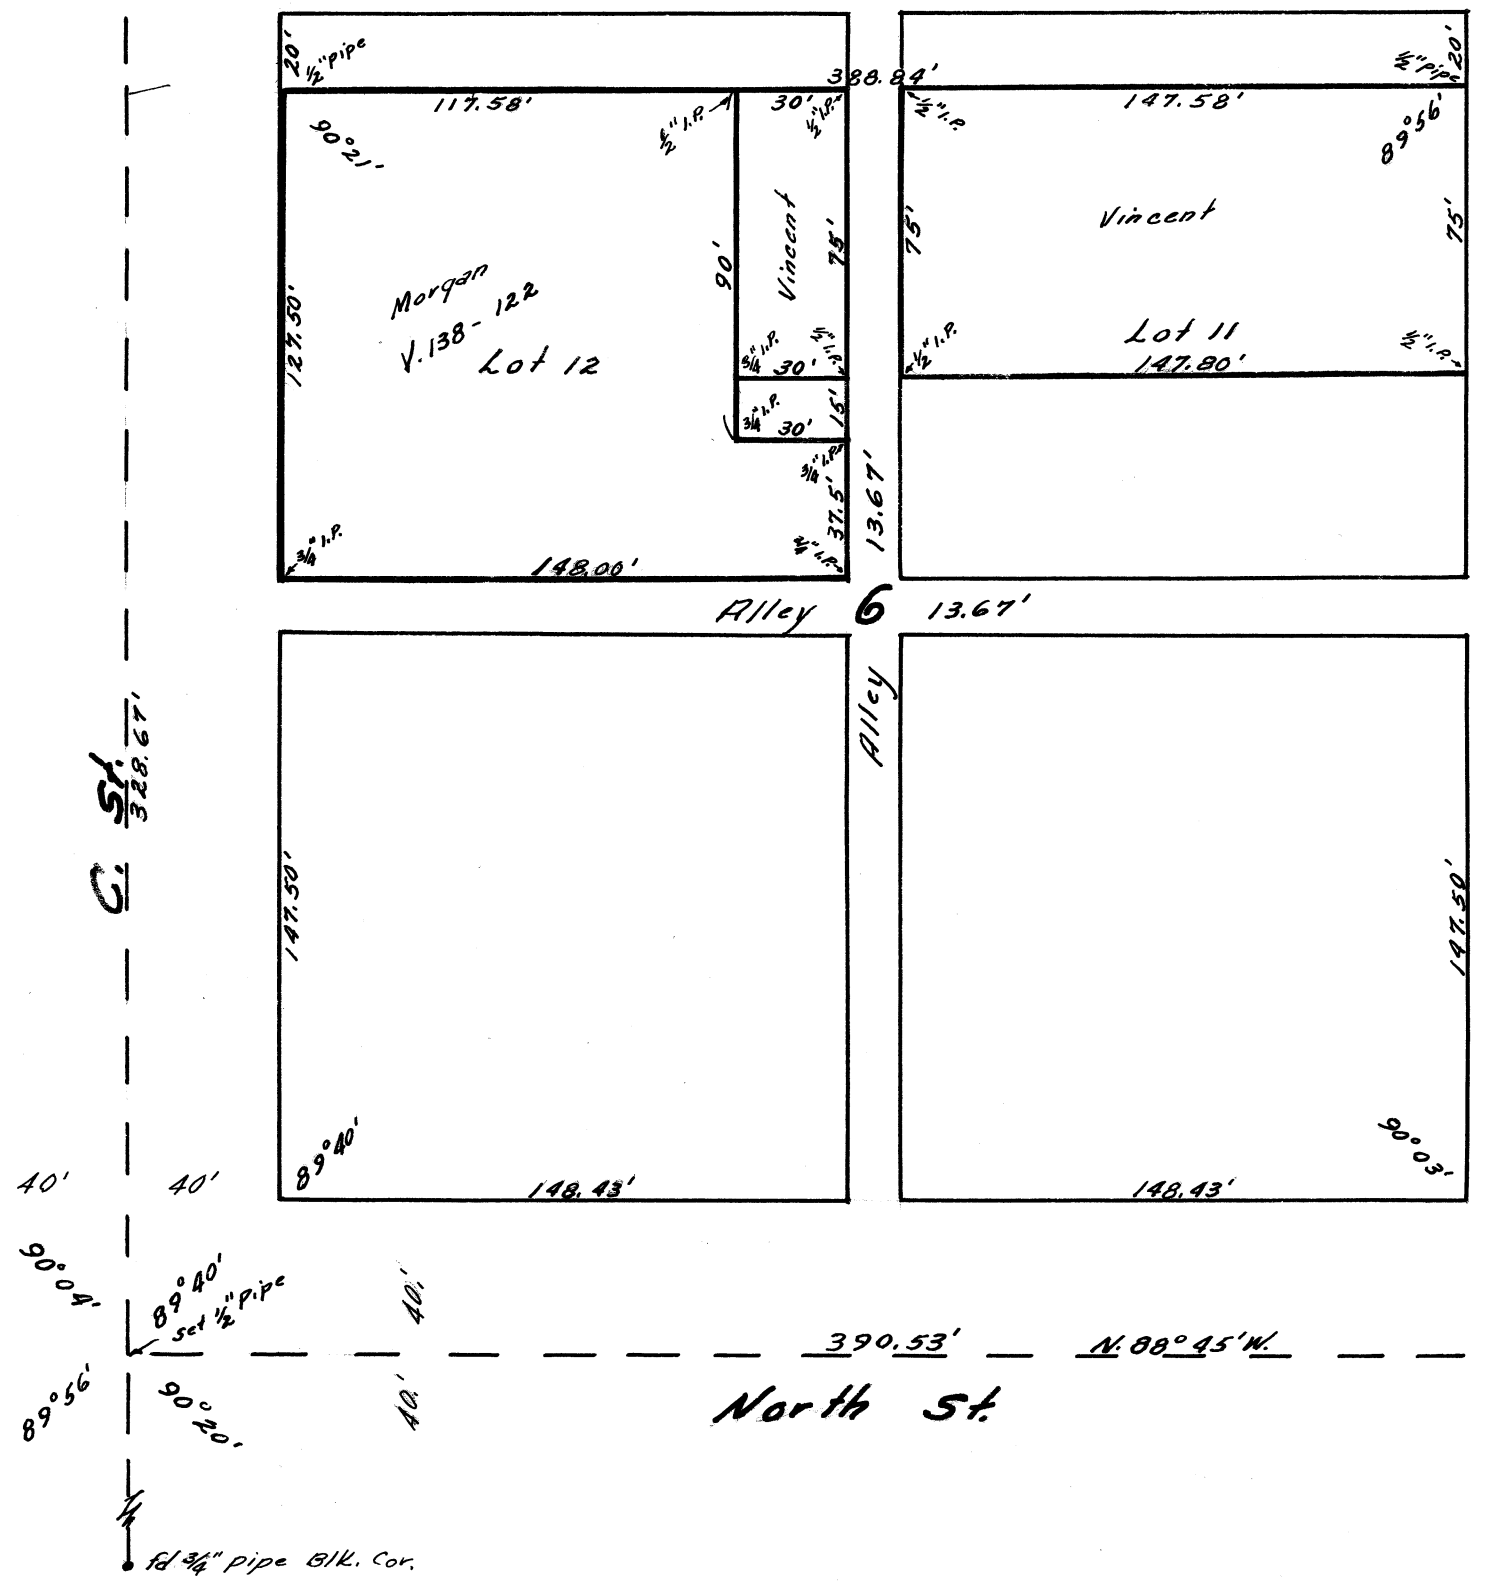

REGISTERED  
OREGON  
LAND SURVEYOR

*J. W. Hanna*  
NOV. 6, 1953  
J. W. HANNA  
306

