

2897

BLOCK 6

N. B. and P. Avery's ADDITION

CITY OF Corvallis


12.50
20.00
2.22
40.00
20.00
10.00
10.00
41.773
41.883
27.74
74.42

61318
53

20.52
10.00
10.00
27.485
24.25
49.75

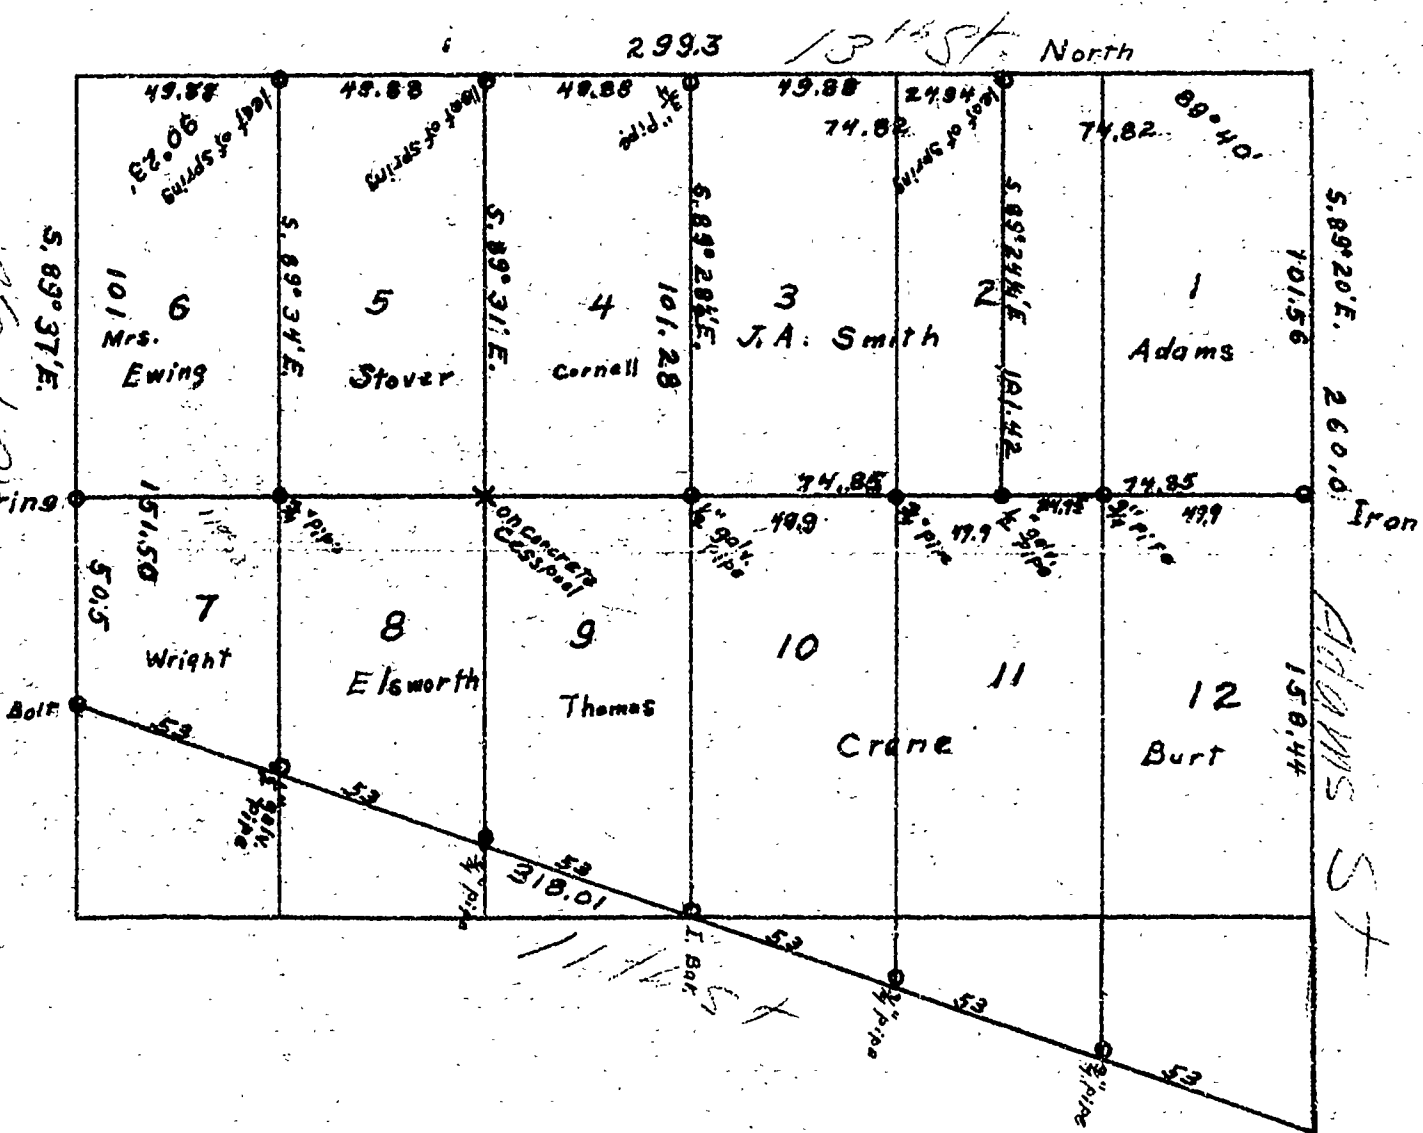

151.50 =
150.00

10954.57

43