


Survey Made For E. J. Newton
Feb. 1919 7th St.

2908

Washington St.

215.00

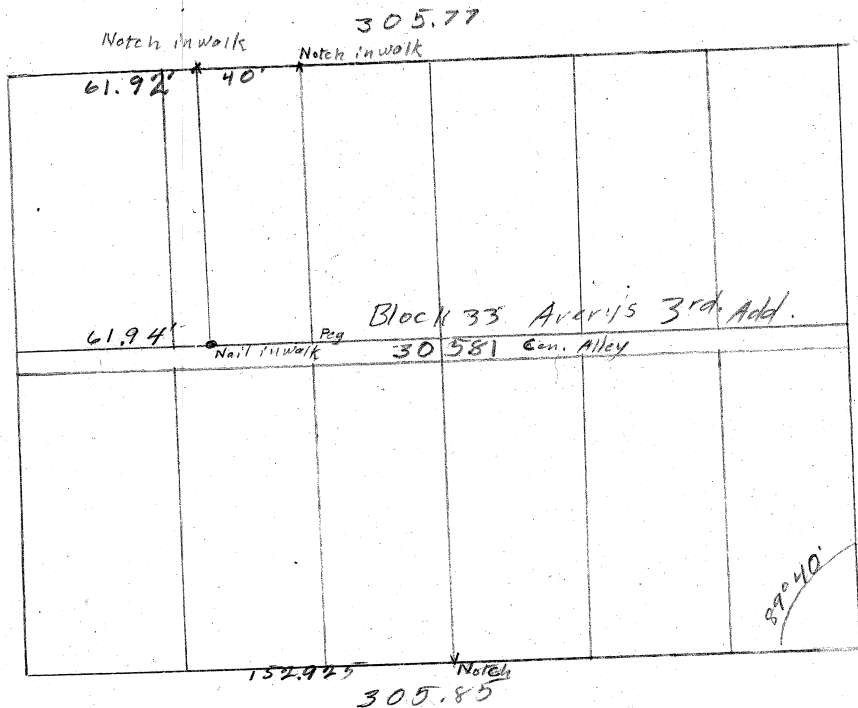

2908

216.08

Adams St.

6th St.