


C. S. No. 2976  
 KENNETH SUTTER  
 SEC. 23, Samuel Gage D.L.C. No 57  
 T. 12 S., R. 5 W., W. 1/4.  
 Benton County, Oregon

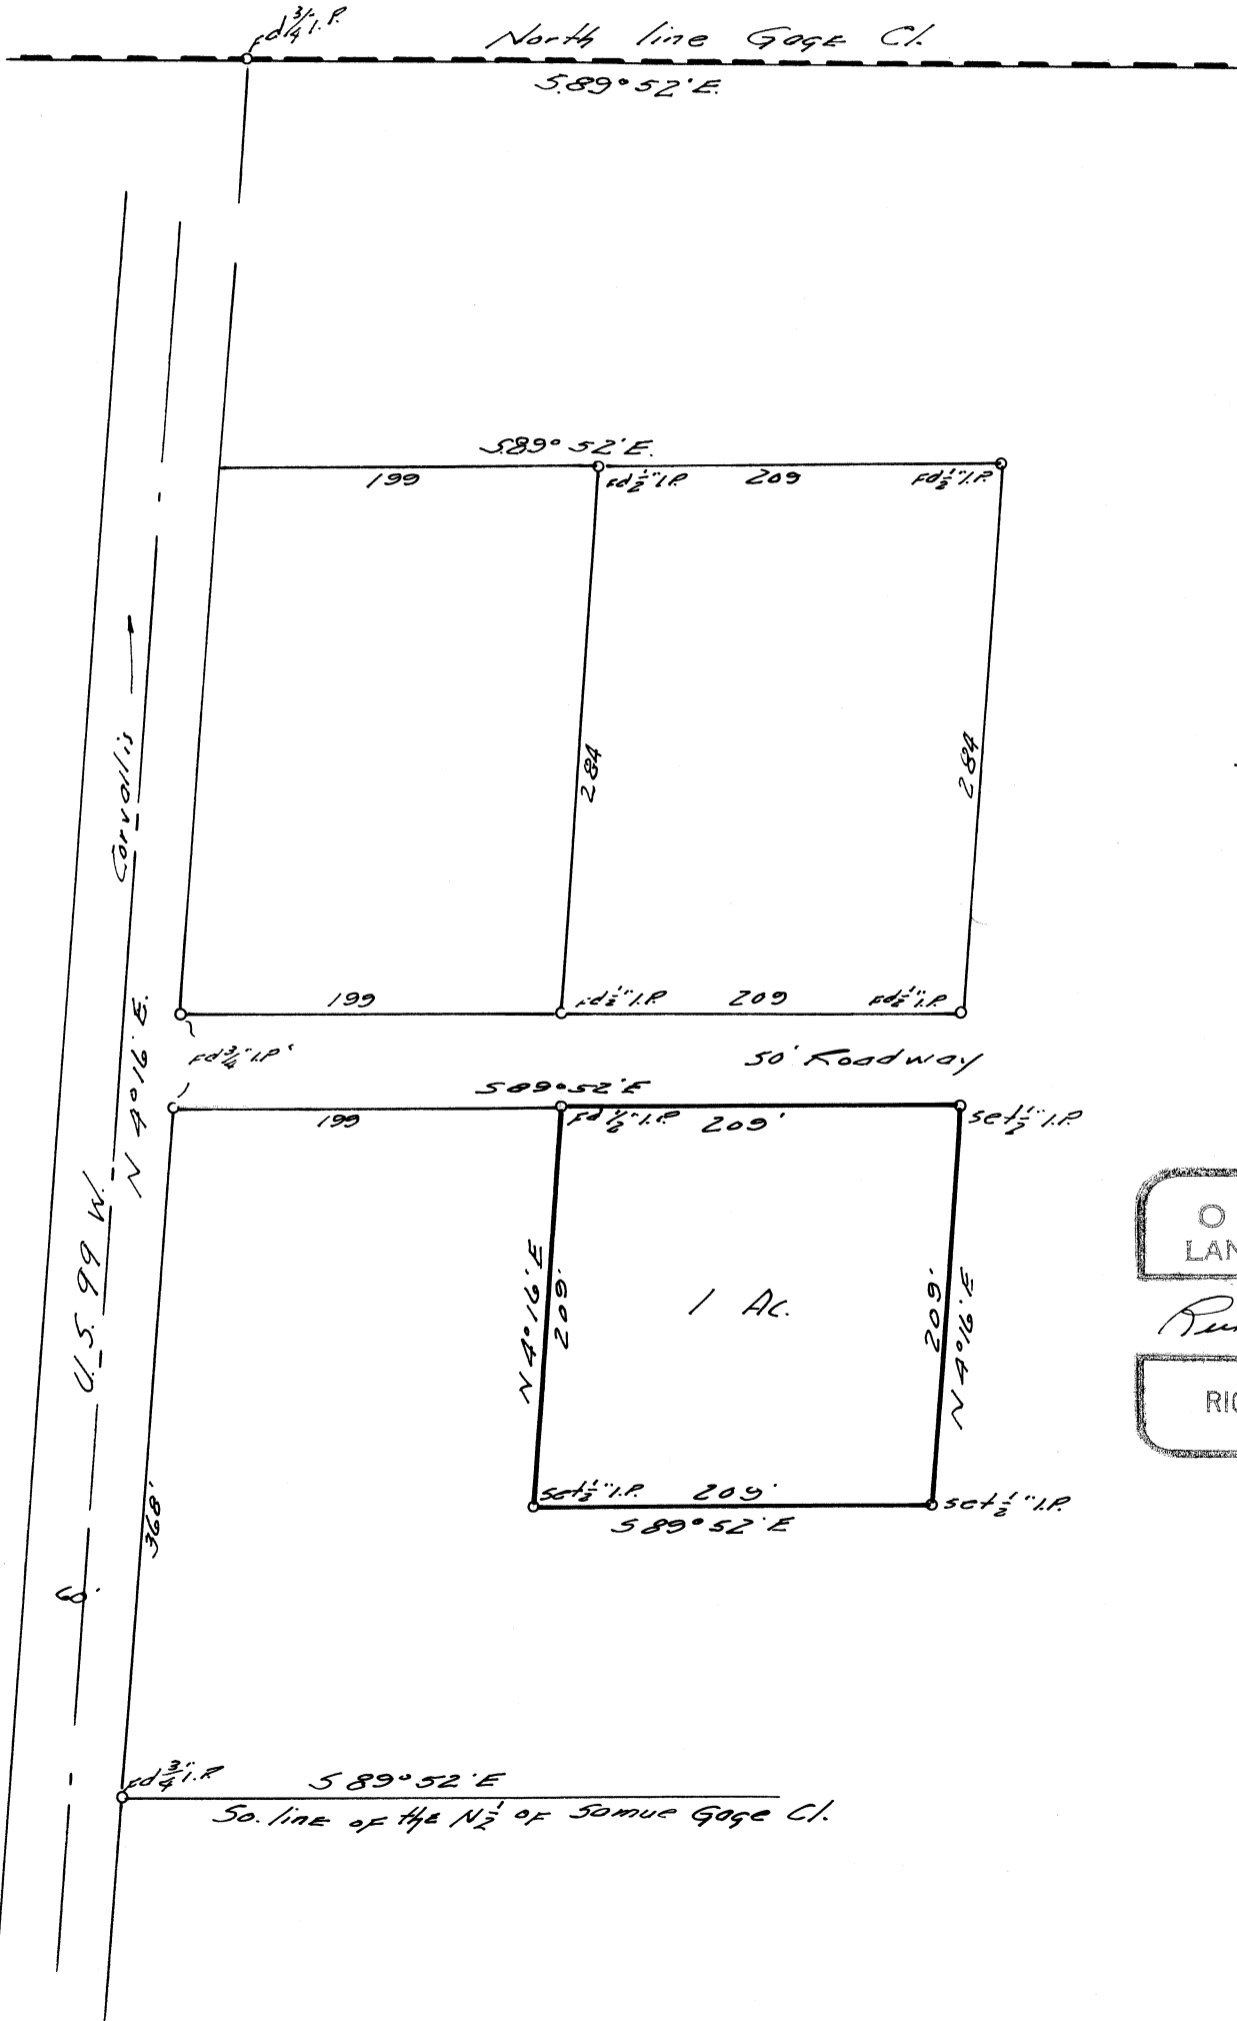

1" = 100'  
 JUNE 15, 1957

REGISTERED  
 OREGON  
 LAND SURVEYOR  
*Richard W. Fail*  
 NOV. 4, 1955  
 RICHARD W. FAIL  
 357