




C.S. No. 2992
 Survey for H.I. SHAW
 in
 Corvallis, Oregon
 Survey of Deed, book 116, page 757

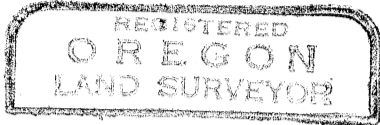

Richard W. Fail

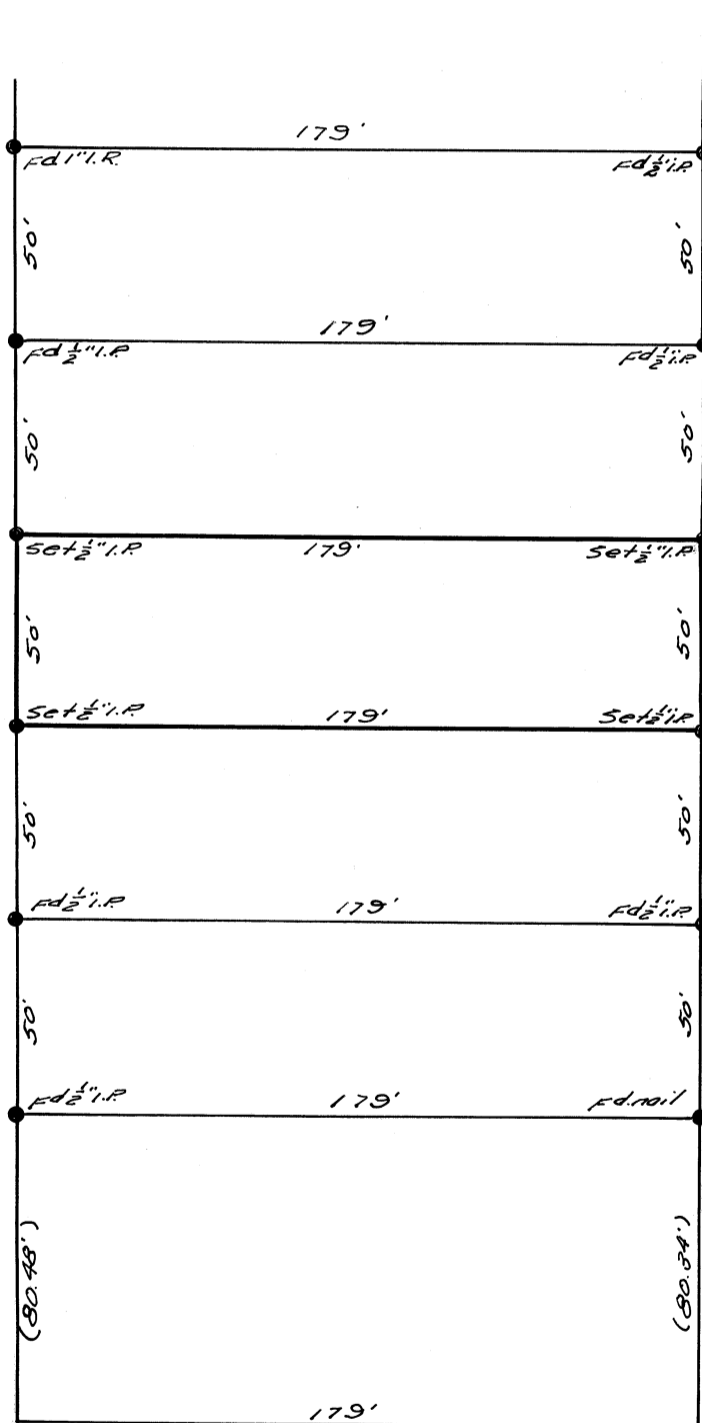

1" = 50'
 9-7-57

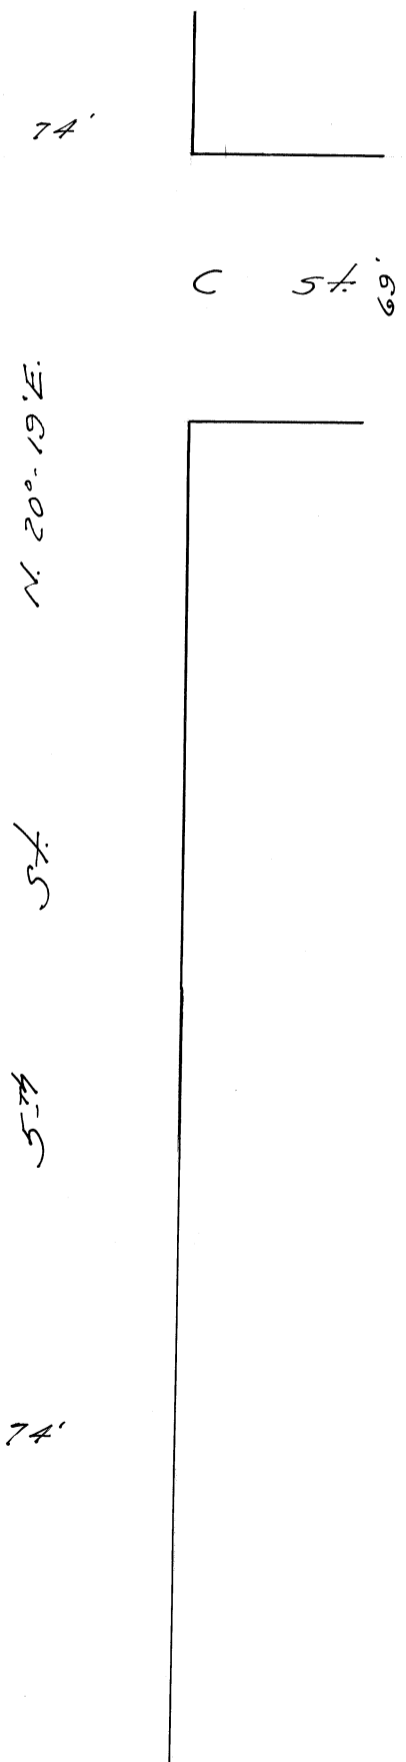

0 5 \frac{1}{2}' 60'