


NO. R - 974
 SURVEY FOR
 CORVALLIS SAND &
 GRAVEL CO.

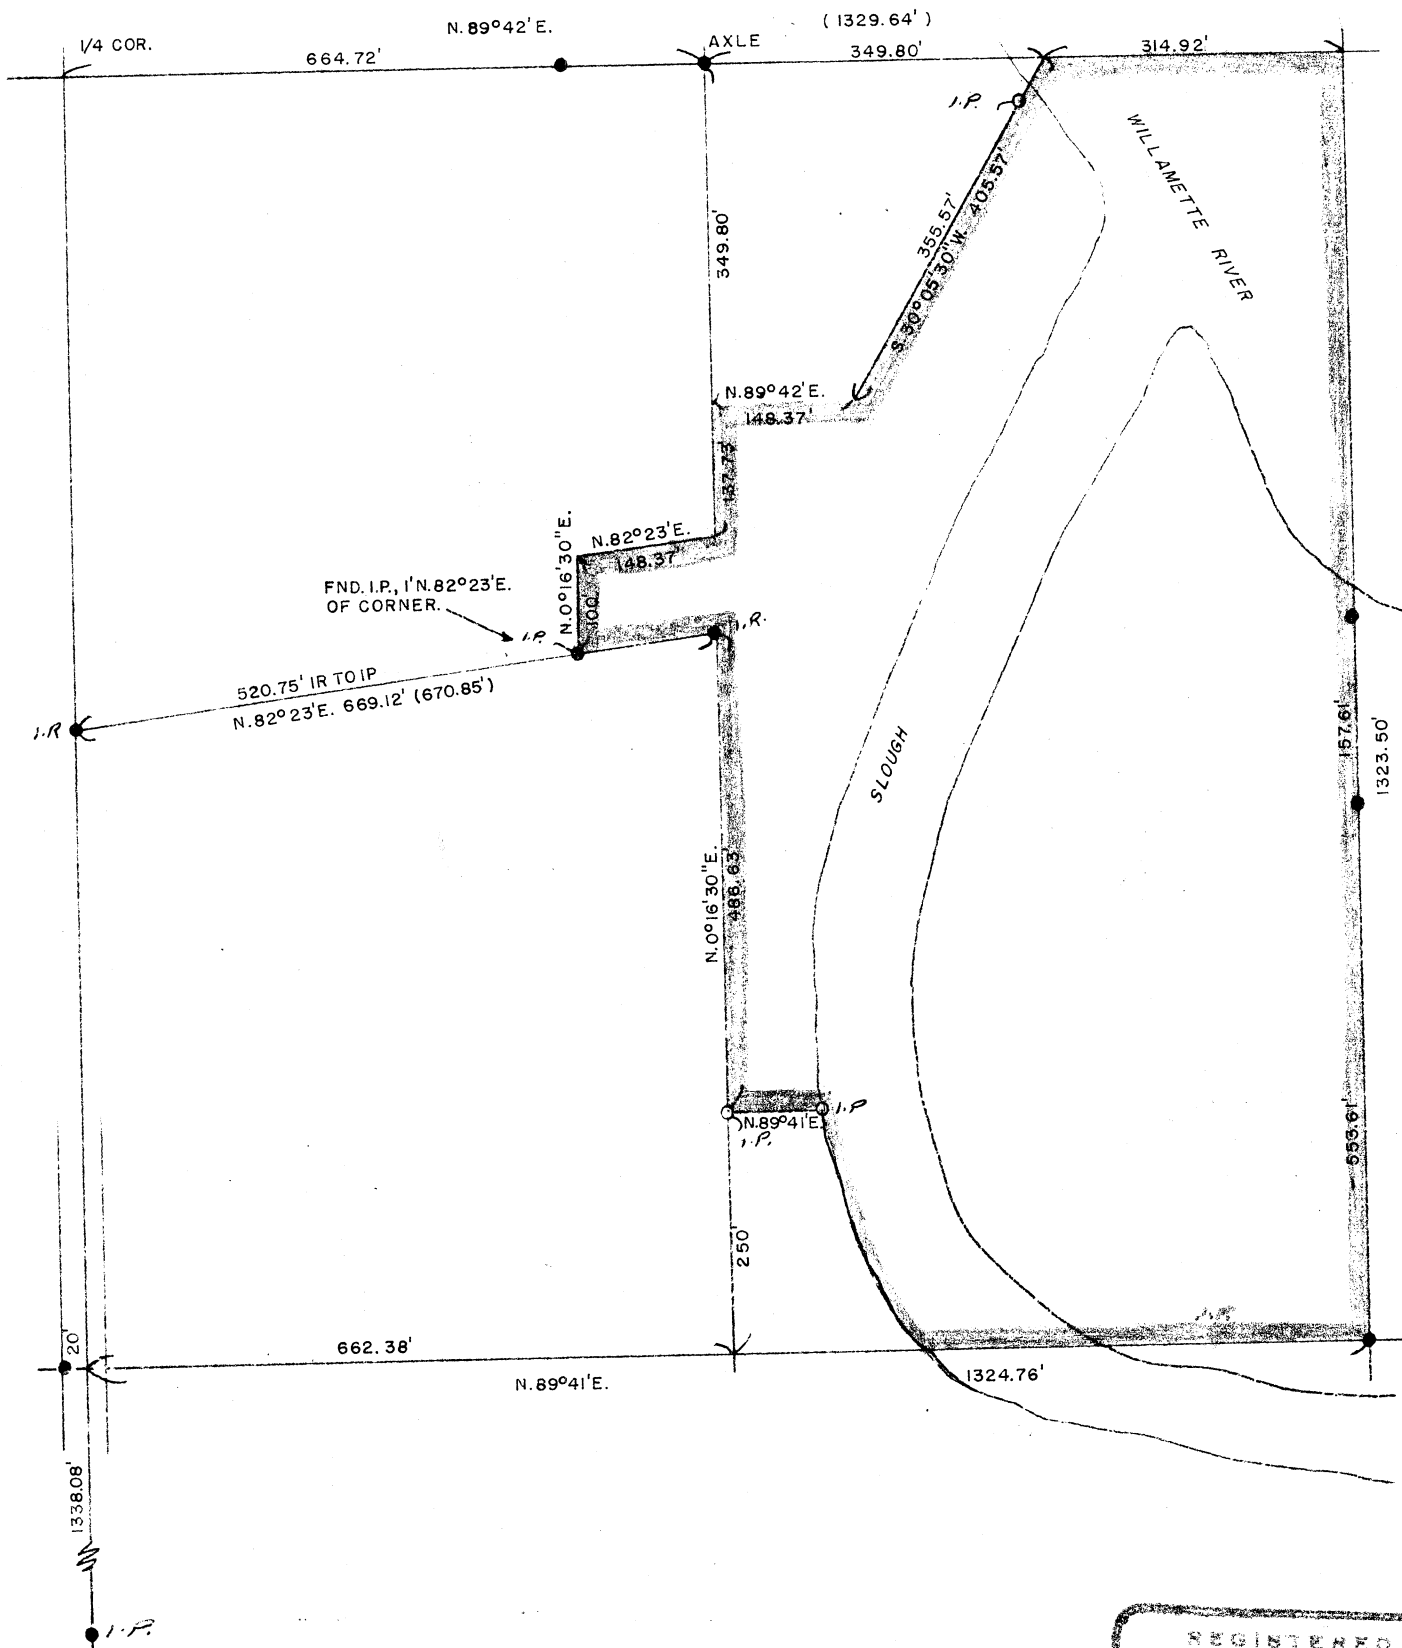

12 OR 5 W.W.M. SEC 13

BENTON COUNTY
 OREGON

RALPH G. BARNES
 LAND SURVEYOR
 990 Shipping St.
 Salem, Oregon



12-17