

Telephone  
PLaza 2-1733


CONRAD COOK  
Registered Land Surveyor

4450 West Hills Road  
Cortallis, Oregon

Job No. 502 Survey for Mr. & Mrs. Fred Plympton Date Dec. 8, 1958

in  
T 11 S, R 5 W, W.M.  
Benton County, Oregon

Scale: 1" = 200'  
C.S. 3204

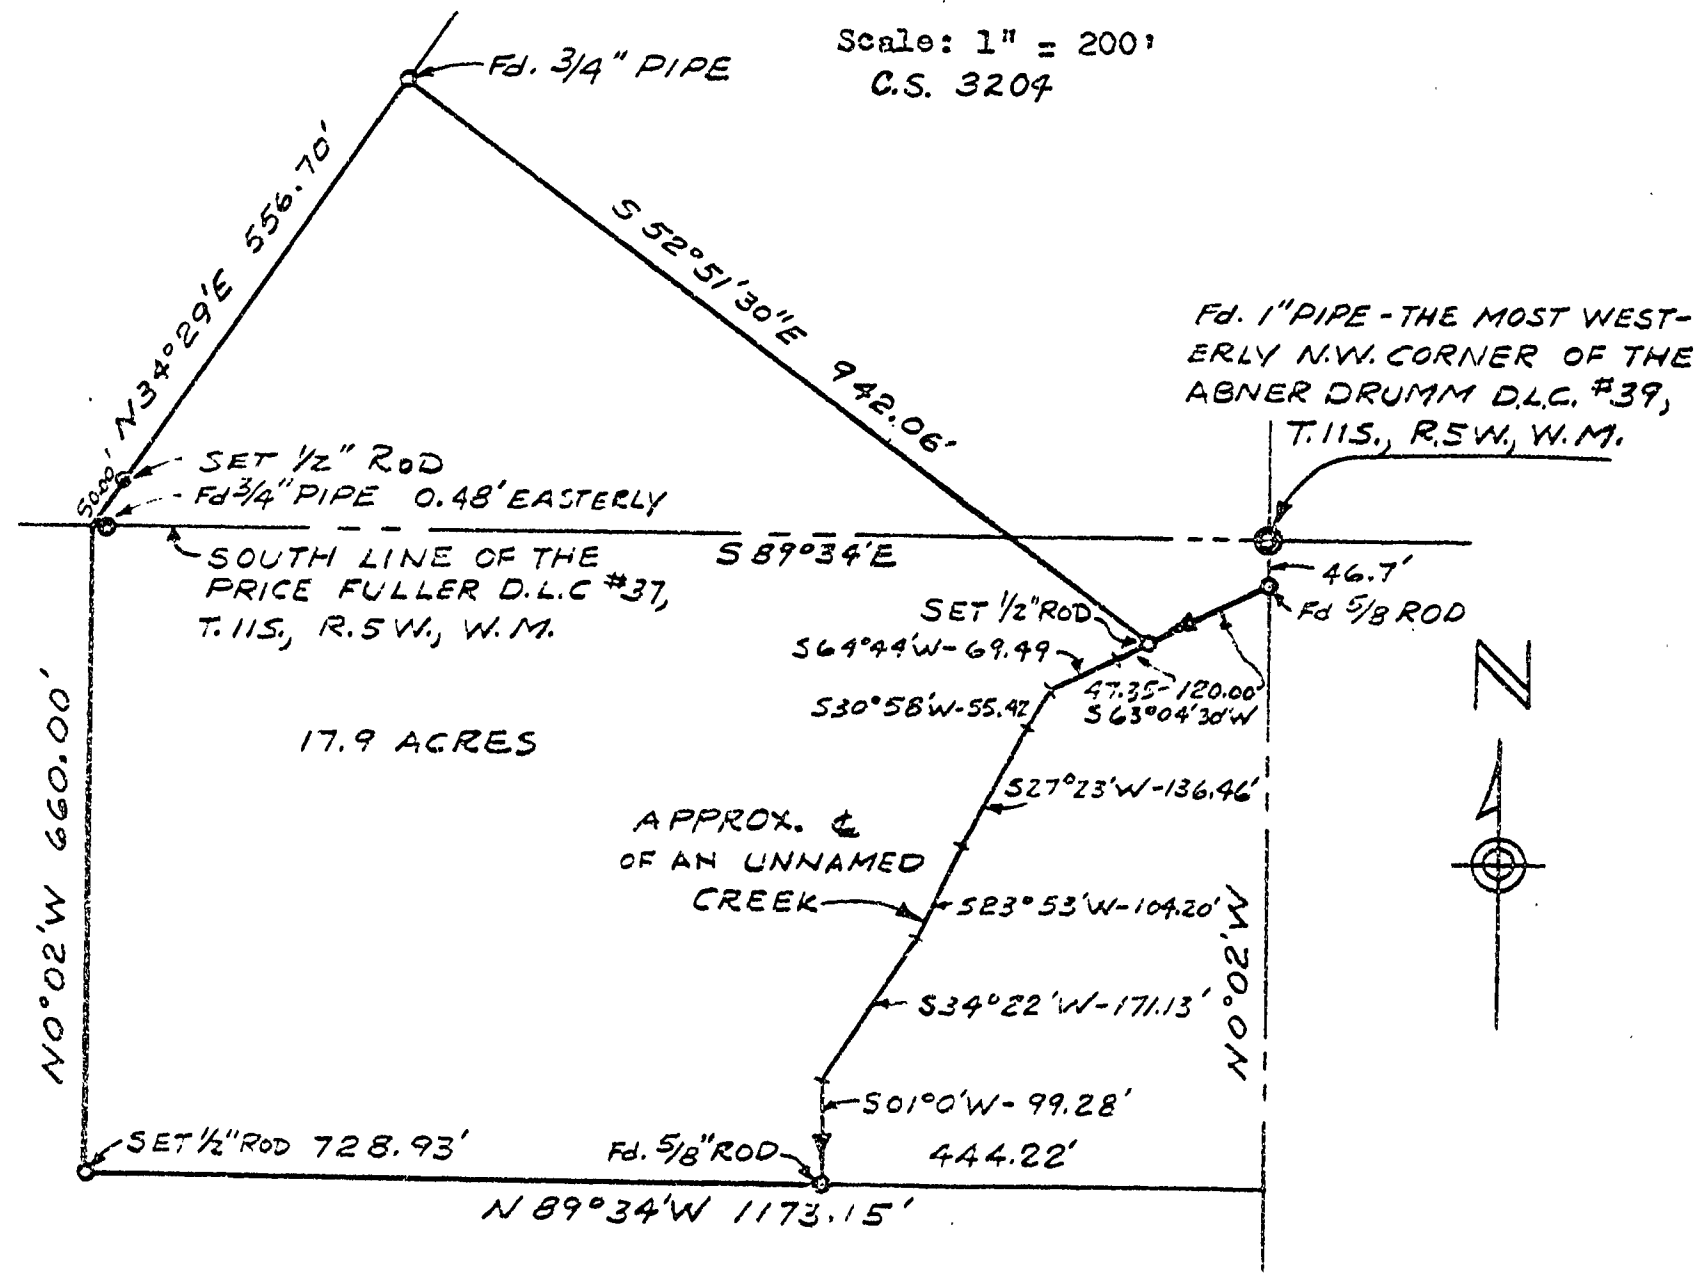

REGISTERED  
OREGON  
LAND SURVEYOR

*Conrad Cook*

NOVEMBER 4, 1957  
CONRAD COOK