


CS 3218

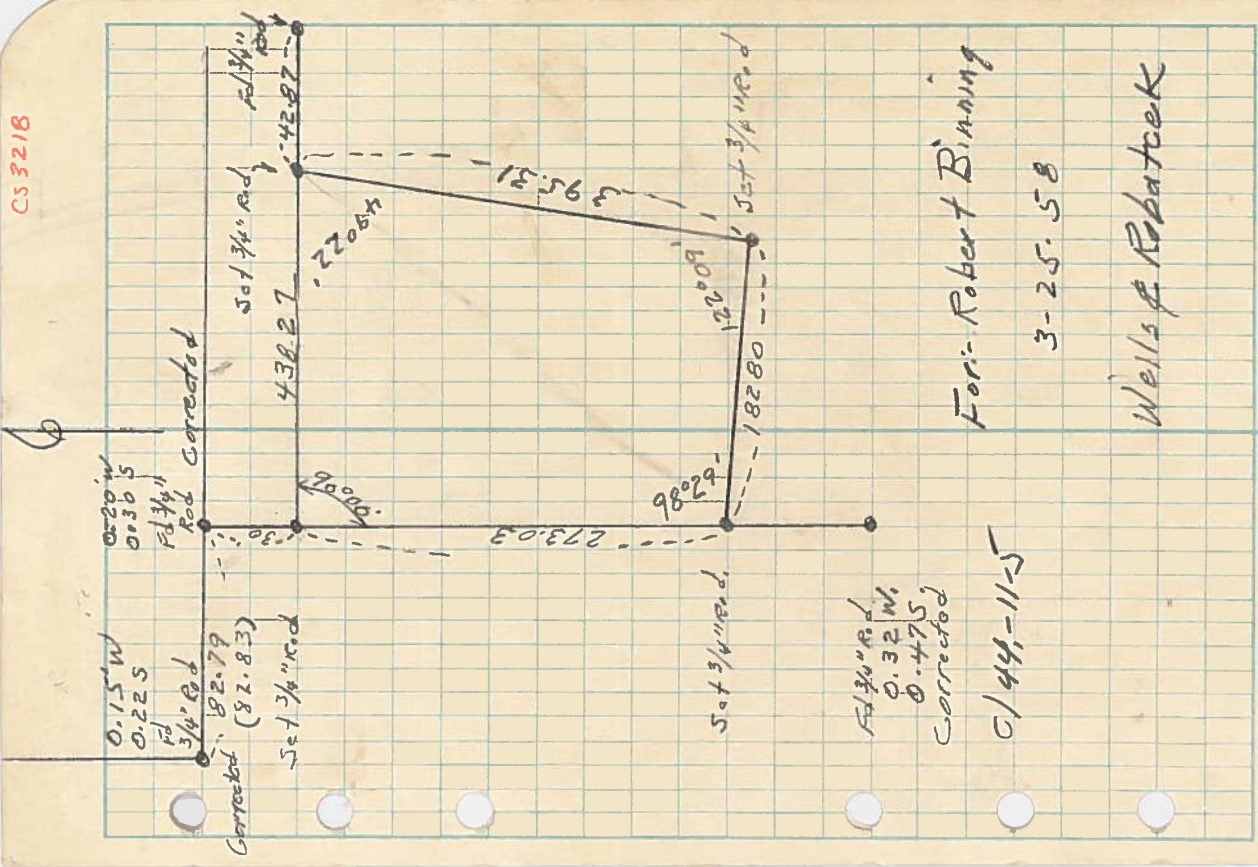

For: Robert Binning

3-25-58

Wells & Bhattek

C/44-11-5

Set 3/4" rod
0.32 W
0.47 S
Corrected

BOOK - FORM 300
FILLER - FORM 301
LOOSE LEAF - FORM 302

W. B. Bhattek