

C. S. 3252


J. THOMPSON

Sec. 17, T. 12 S., R. 7 W., W.M.

Scale: 1" = 30 chains

June 4, 1959

Bearings are based on U.S.C. & G.S. bearing from Marys Peak to Prairie Mountain.

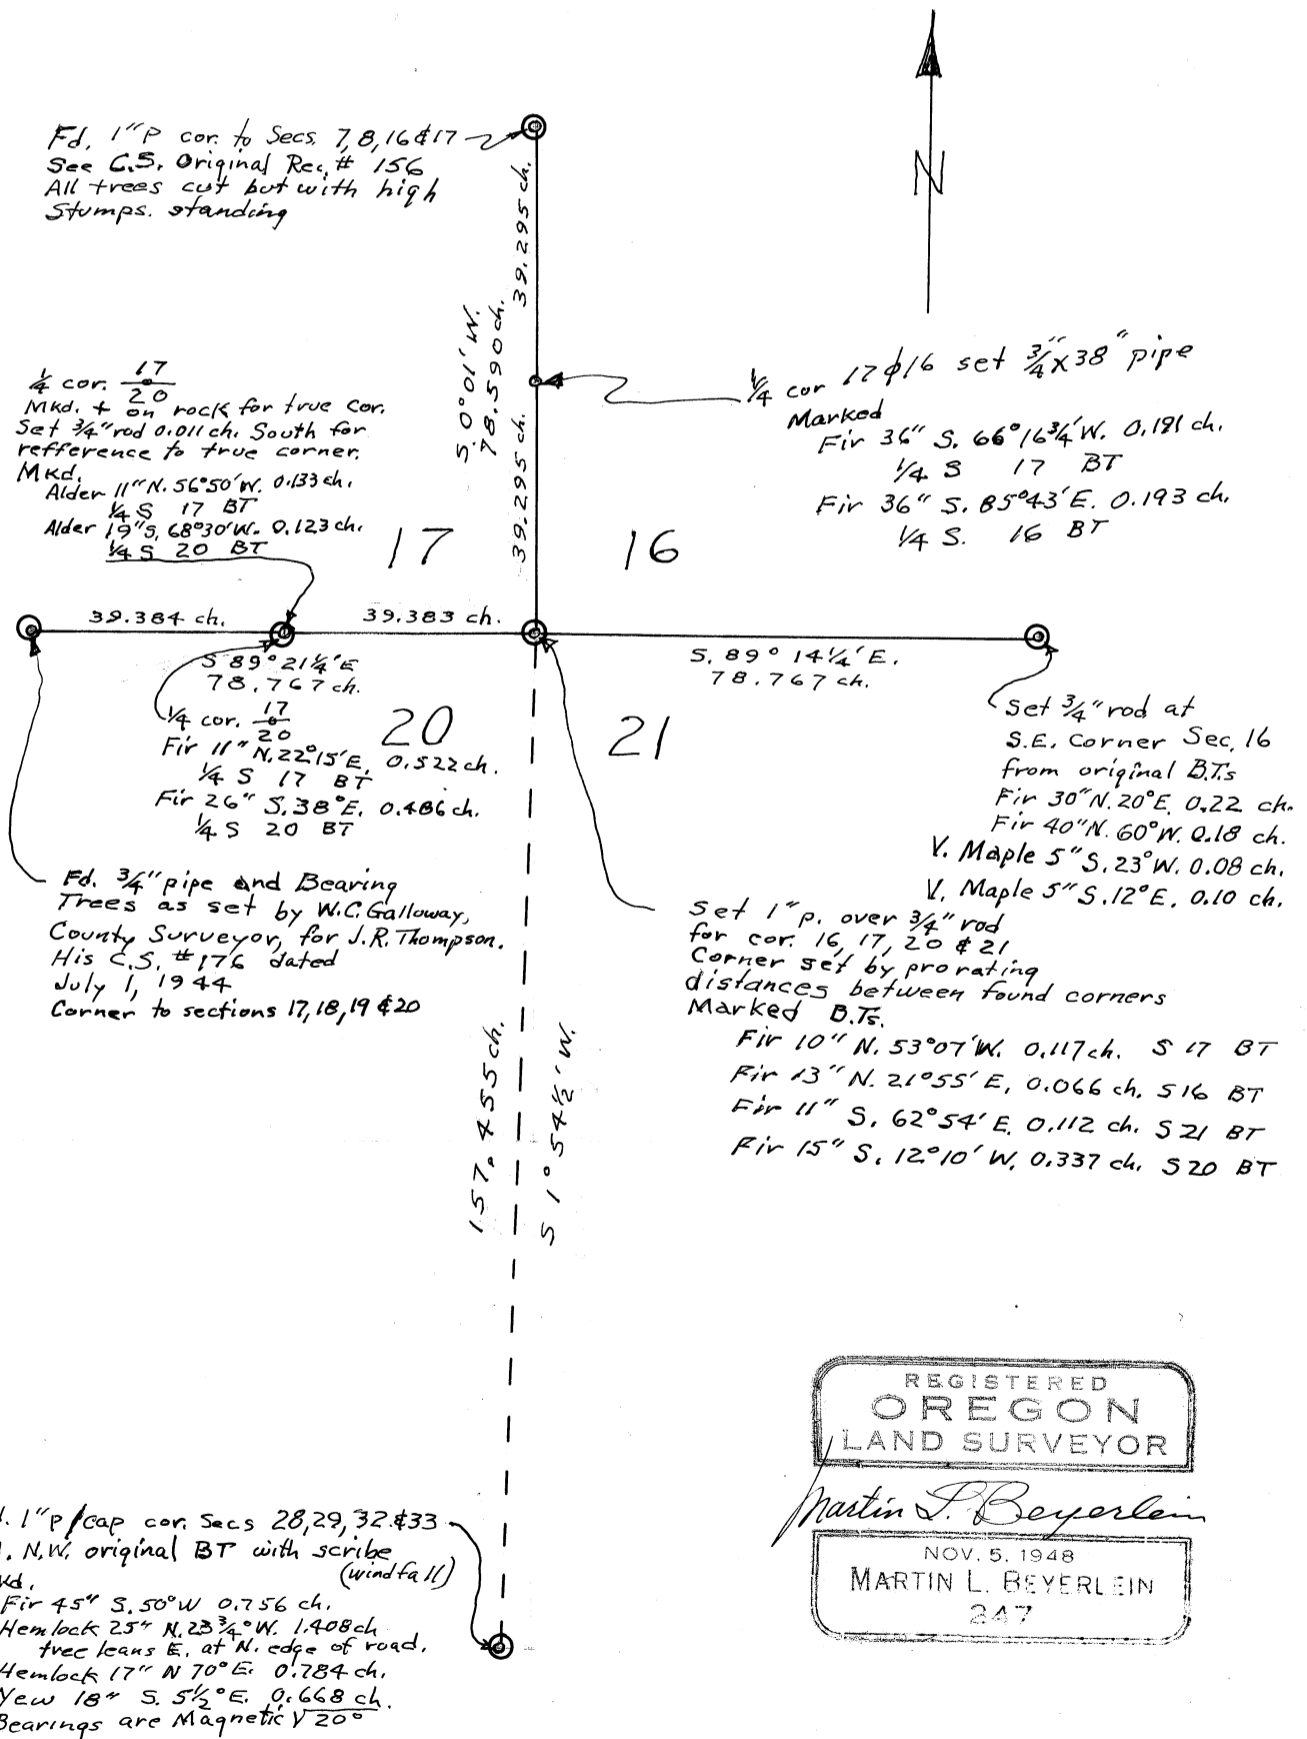

REGISTERED
OREGON
LAND SURVEYOR

Martin L. Beyerlein

NOV. 5, 1948
MARTIN L. BEYERLEIN
247