

CS 3278
Survey
for


4

LEO P COX

D.L.C. 43, T.10S., R.4W., W.M.

Scale: 1 in. = 50 ft
July 1959

C.W. Dane
Corvallis, Ore.

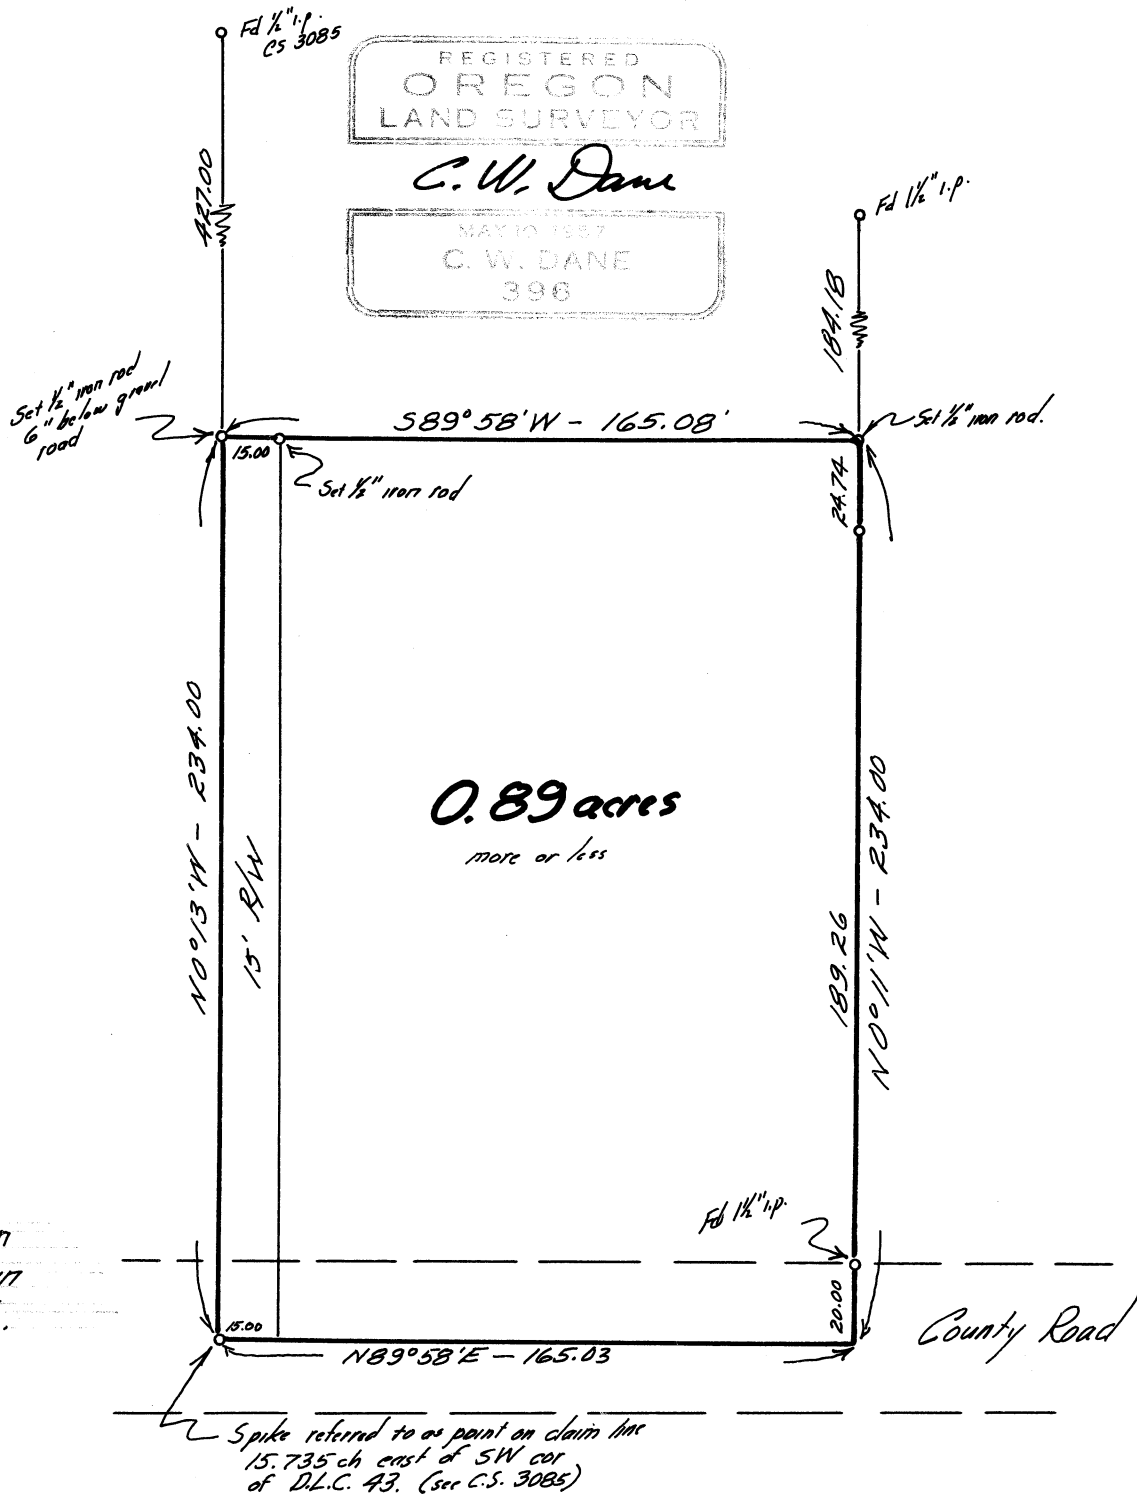

Bearings based on east line as shown on CS 3085.