


N

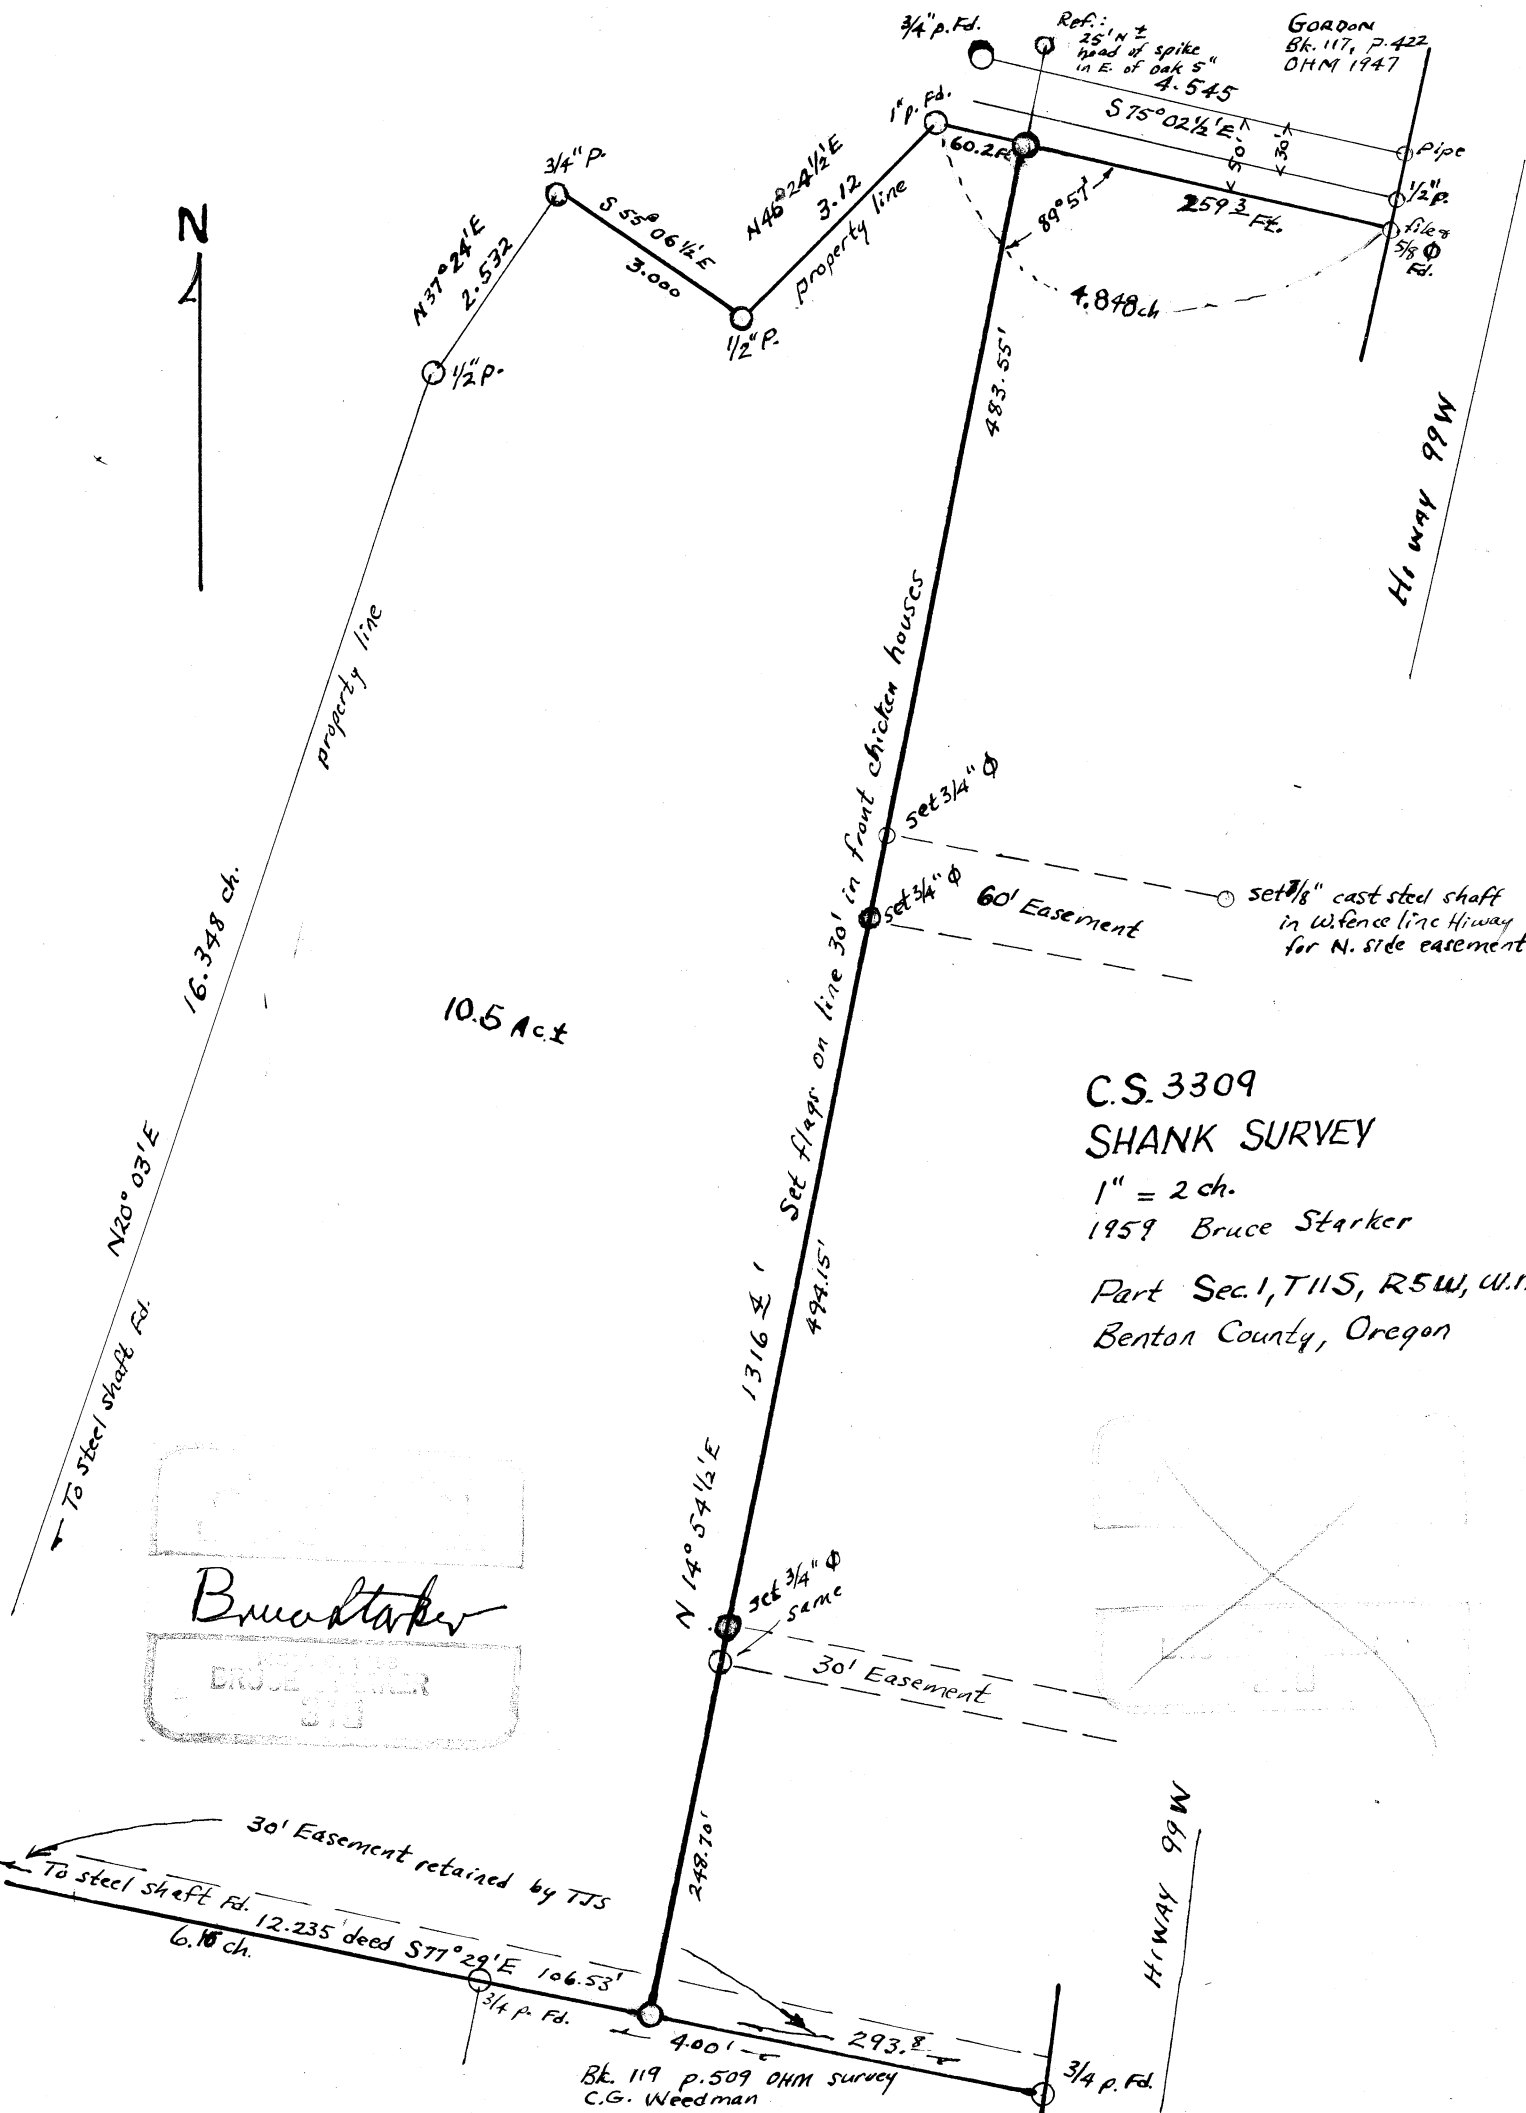

**C.S. 3309
SHANK SURVEY**

1" = 2 ch.
1959 Bruce Starker

Part Sec. 1, T11S, R5W, W.M.
Benton County, Oregon

Bruce Starker
BRUCE STARKER
SIS

