


C. S. 3393  
 Mrs. H. W. Murphy  
 S.M. Stout, D.L.C. No 48  
 T.115. R.5W, W.B.M.  
 Benton Co., Ore.

REGISTERED  
 OREGON  
 LAND SURVEYOR

*Richard W. Fail*

NOV. 4, 1958  
 RICHARD W. FAIL  
 357

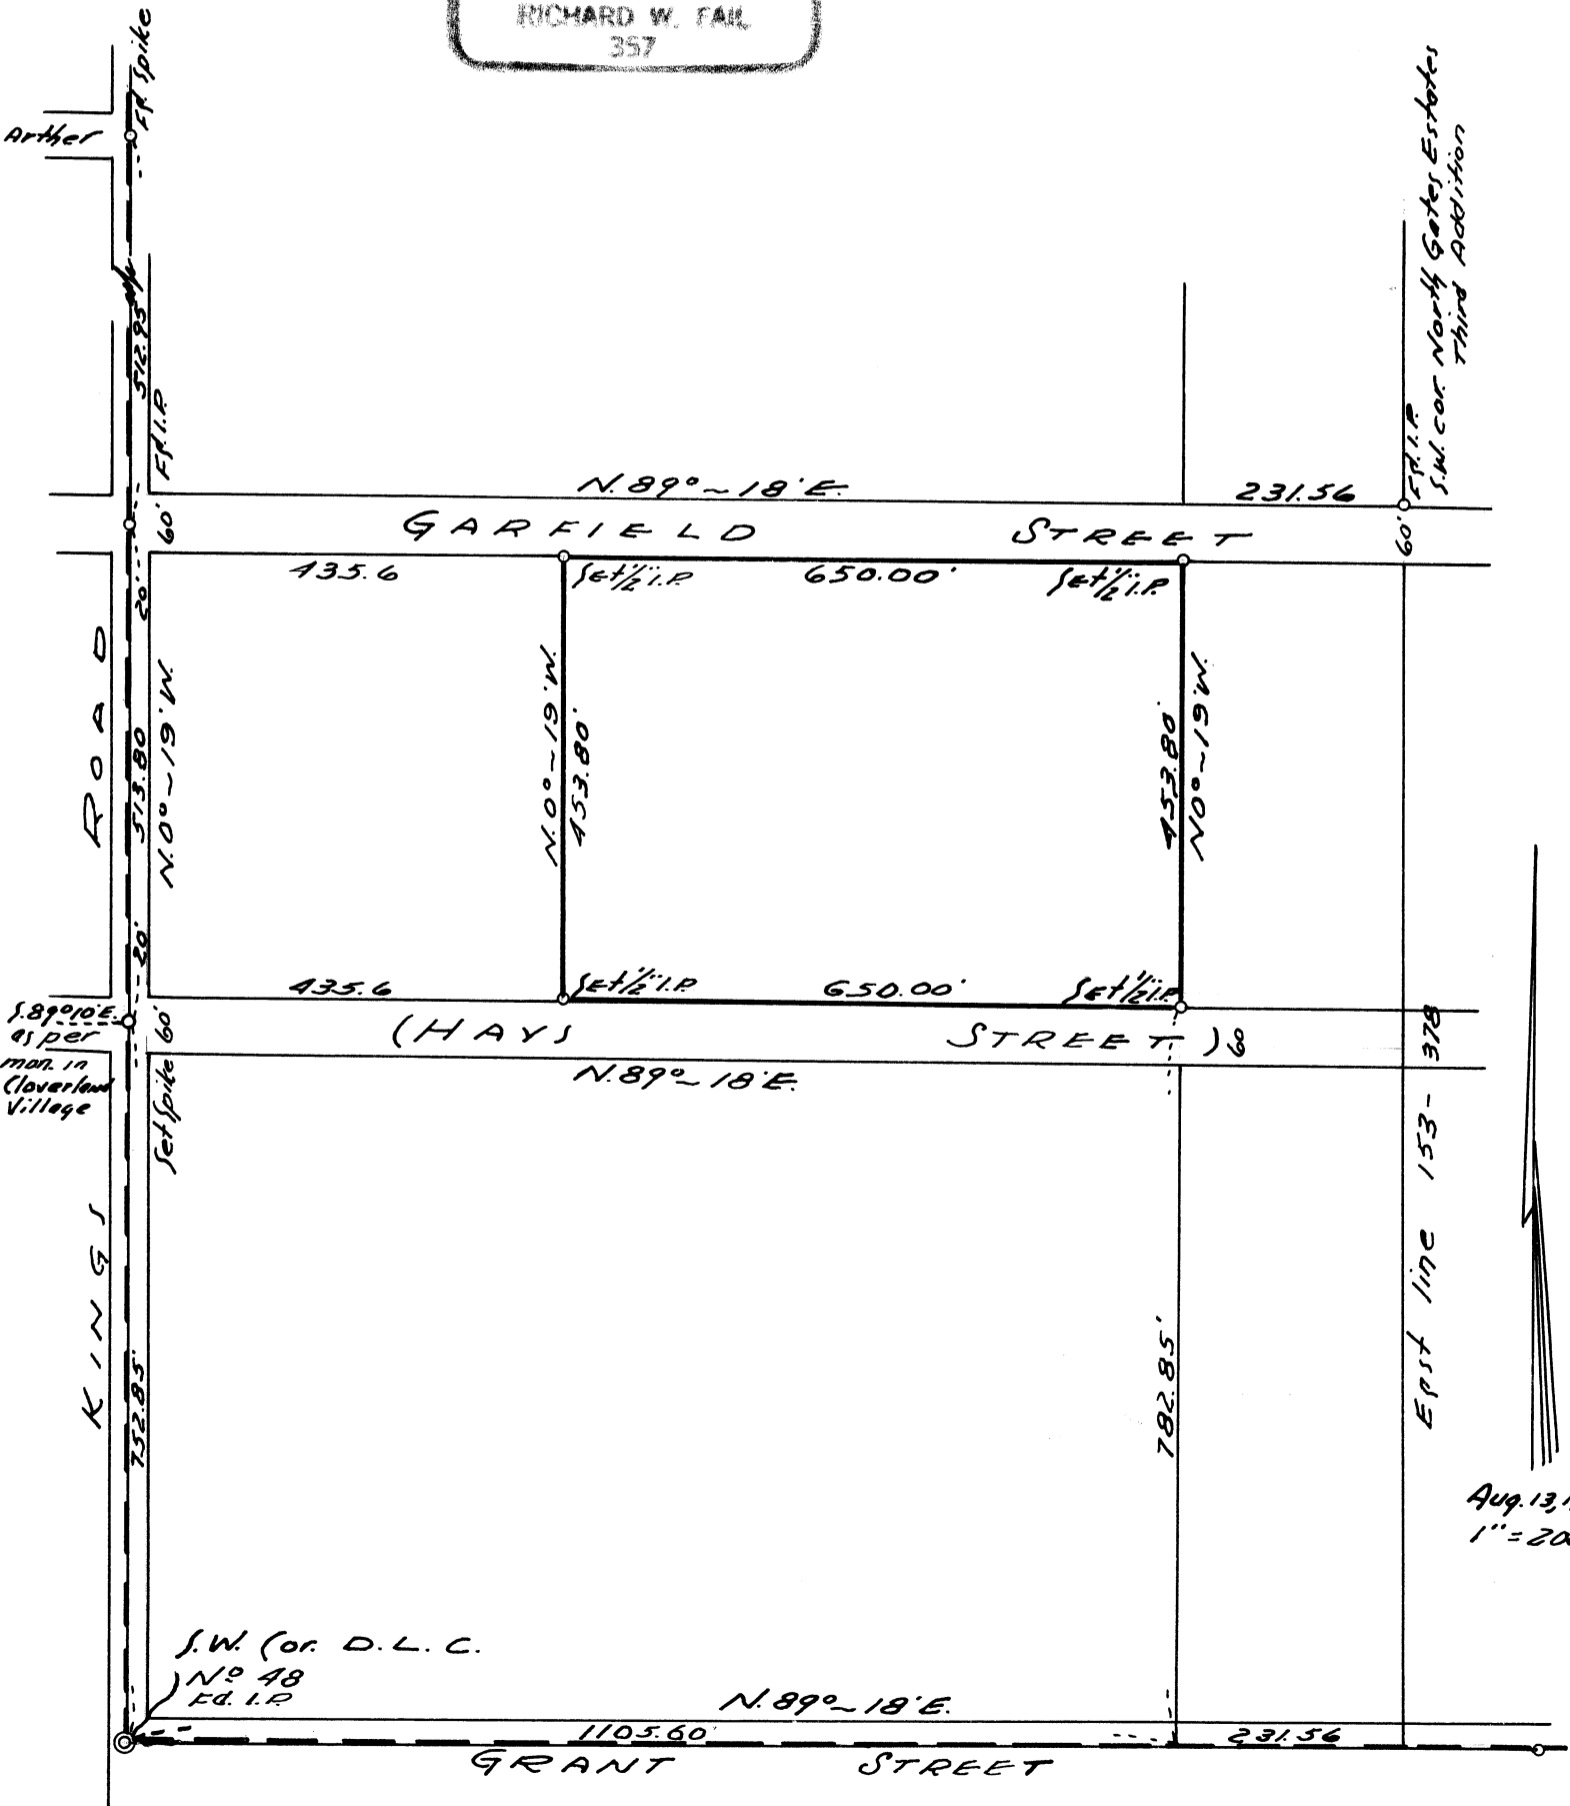

F.I.P.  
 S.W. cor. North Gater Estates  
 Third Addition

Aug. 13, 1960  
 1" = 200'

S. 89° 01' E.  
 as per  
 map in  
 Cloverland  
 Village

S.W. (or. D.L.C.)  
 No 48  
 Ed. I.P.