


C.S. 3424  
L.C. ZUMWALT  
Sec. 35, T10S, R4W.  
BENTON CO. ORE.  
Surveyed Oct 19, 1960  
Scale 1" = 50'

REGISTERED  
OREGON  
LAND SURVEYOR

Richard W. Fail

NOV. 4, 1955  
RICHARD W. FAIL  
367

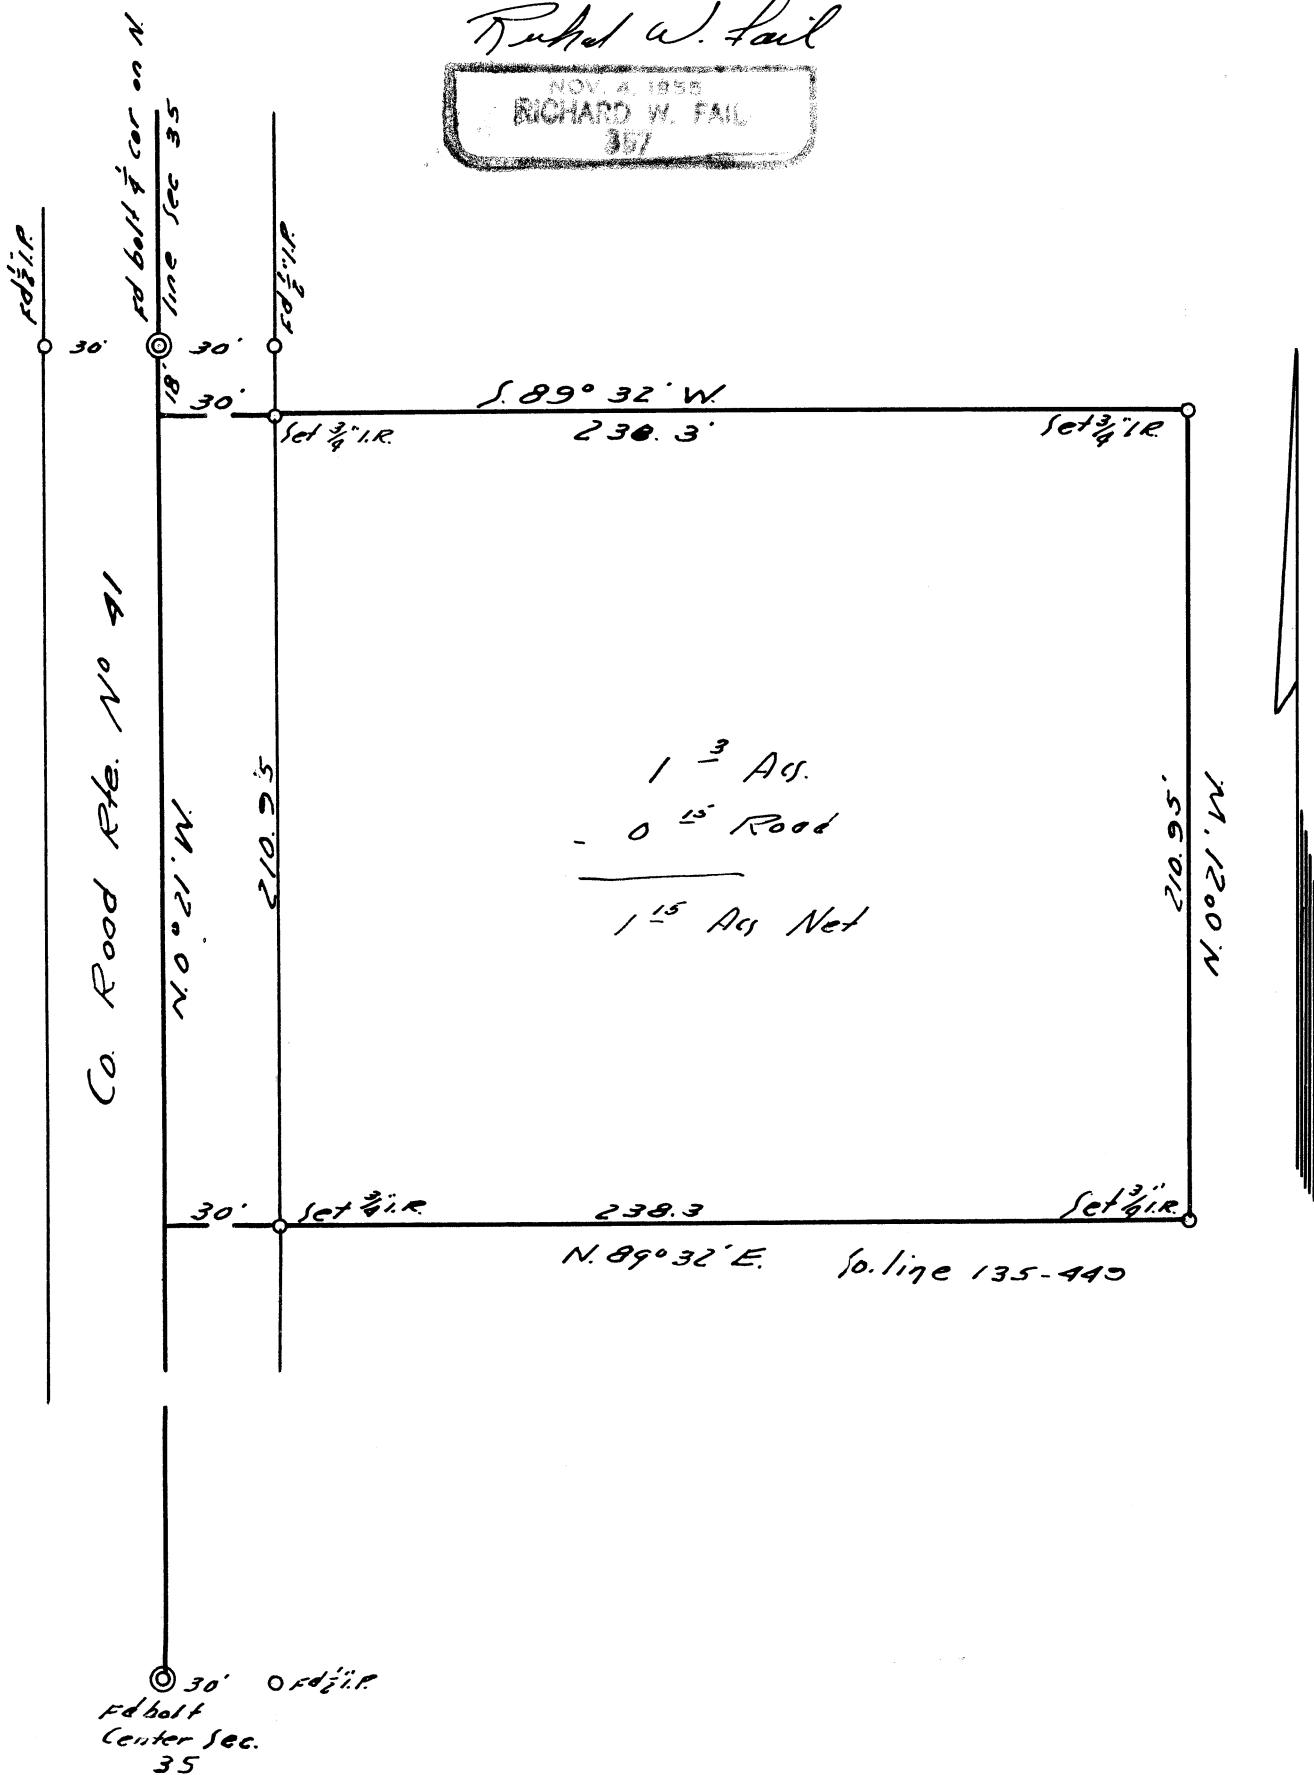

CS3424

Center Sec 26 T10 S, R 4 W

Sec 25 2269  
42651

EAST 13.507


B. 135 P. 49 Acres

13.948  
N0013 E  
26.173

1/2" P. W. 30'  
1/4" P. W. 30'  
Bolt 1/2" P. W. 30'

1/45

DIETRICH NO. 388-3

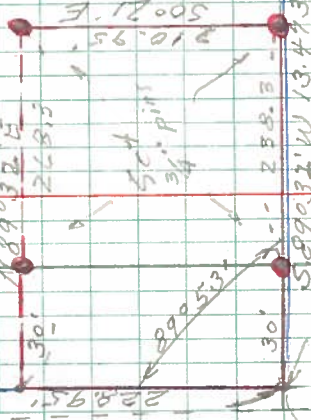

1.15 115'

1.3 Grass

Bolt 30' 1/2" P. W.

Center Sec 35, T10 S, R 4 W

FALL 1960

10-19-60