


SURVEY FOR
EUGENE FENNER
 IN THE WILLIAM MATZGER D.L.C. NO. 50
 T12S, R6W OF WILLAMETTE MERIDIAN
 SCALE: 1" = 40' JULY 7, 1961

C.S. 3533

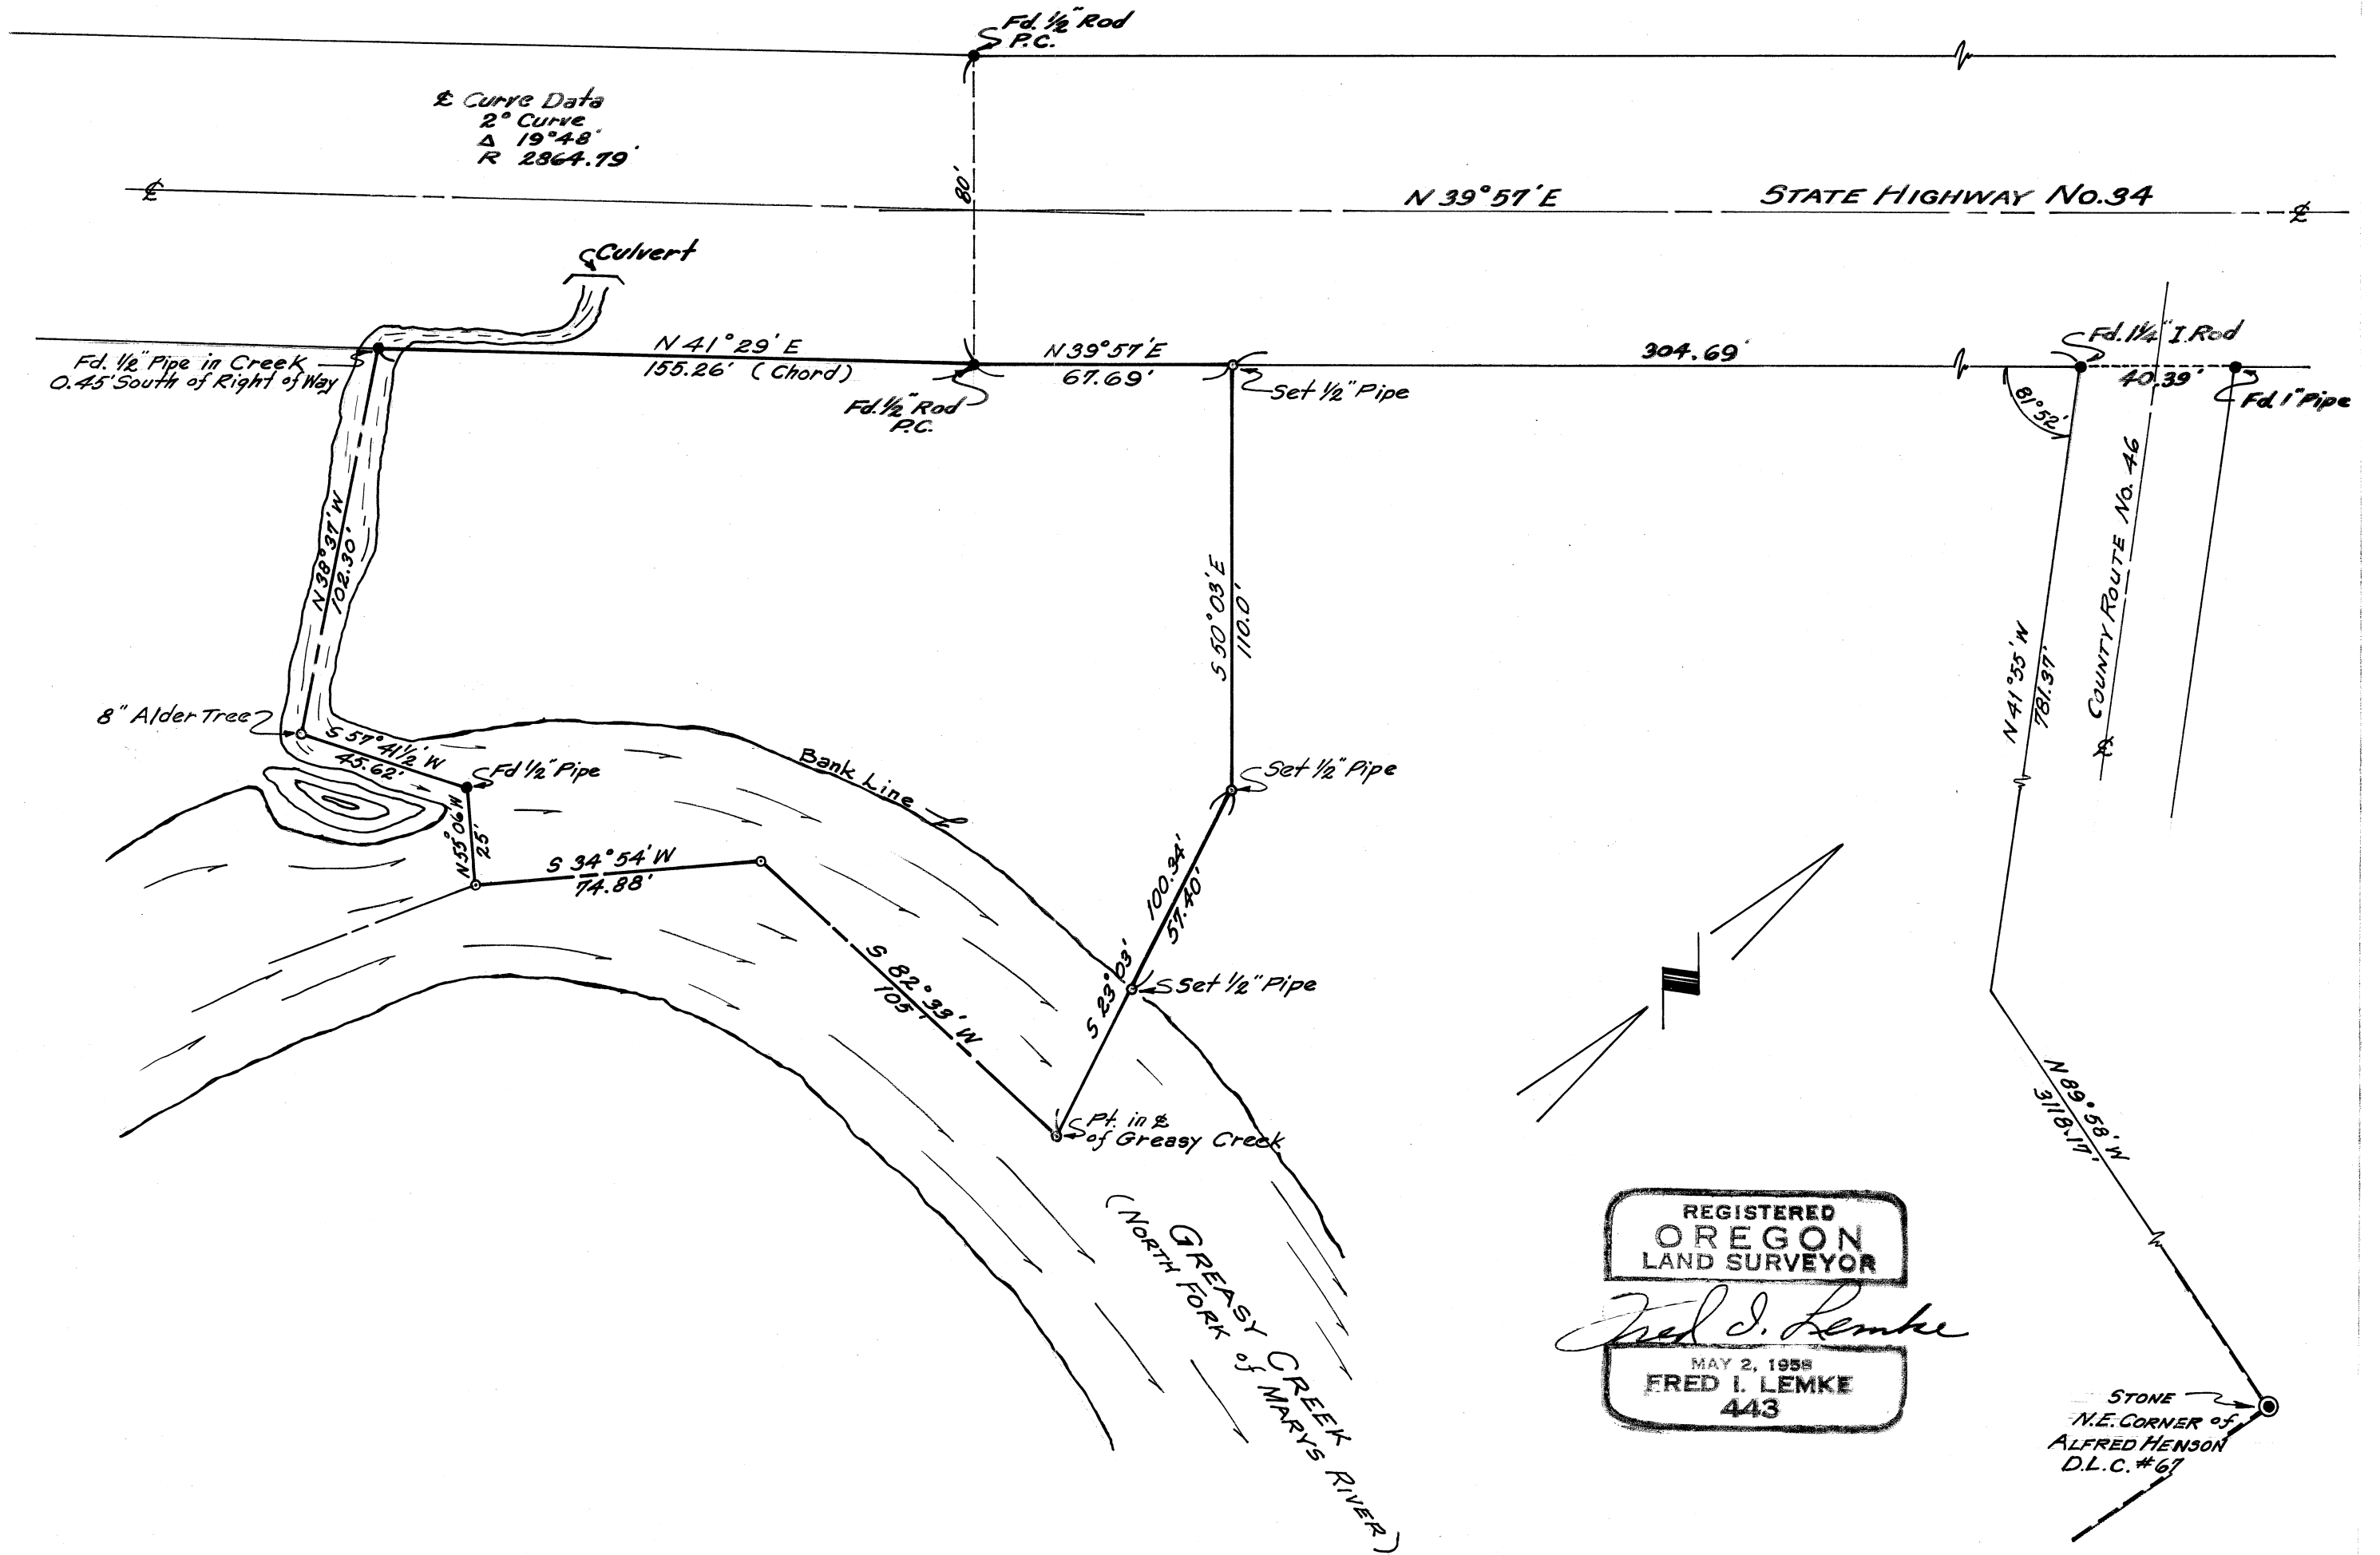

REGISTERED
 OREGON
 LAND SURVEYOR

Fred I. Lemke

MAY 2, 1958
 FRED I. LEMKE
 443

STONE
 N.E. CORNER of
 ALFRED HENSON
 D.L.C. #67