


615. 3563

Record of Survey for
Wesley & Robert Pinnell

DIETZEN NO. 388-3

C.S. 3563

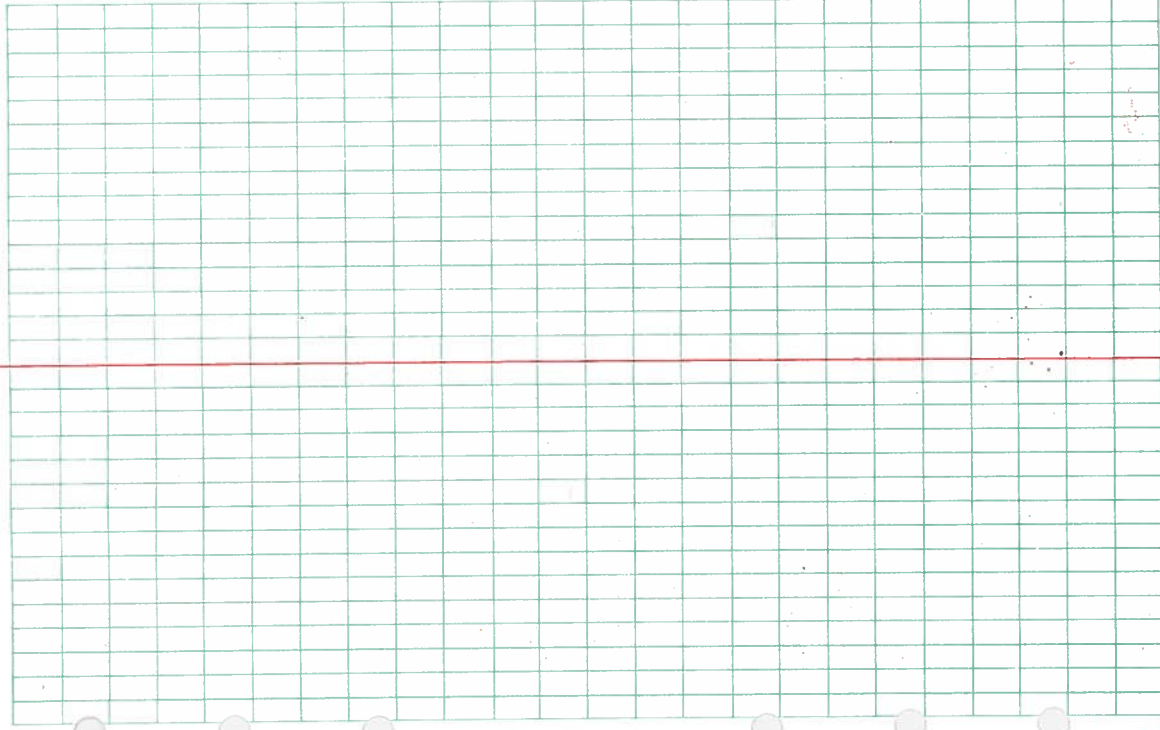

DIETZEN NO. 386-3

Sta. No. 3 Vert. 3 Slope Dist. Hor. Dist.

I Fd 1/2" I.P.
0'00'

30.00

J P.O.T. Set nail

30.00

H P.O.T. - Could not find corner
0'00'

120.00

G Defn Rt 0° 32' Fd 1" I.P. 0.20 E. pl. 11. 2. 0.10 S 86° 16' line

60.00

E P.O.T.

Note: I.P. bet E. & F on good line and

dist as per C.S. 16

C Set nail

30.00

D P.O.T. - Could not find corner here

120.00


A P.O.T.

Note: I.P. bet A & B on good line and

dist as per plat C.S. 16

Dec 2, 1961

CS 3563

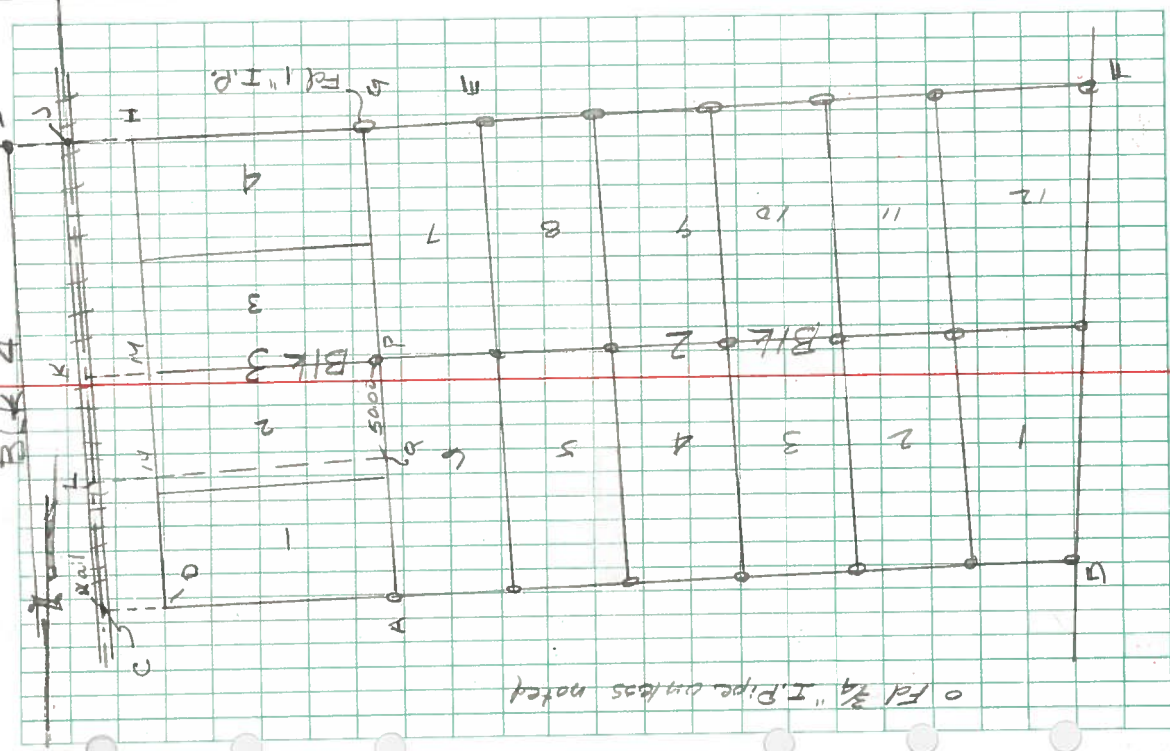

DIETZEN NO. 385-3

N				Set 5/8" I.R.
L	90°37'	0°00'	50.00	
M				
M				Set 5/8" I.R.
K	90°37'	0°00'	50.00	
J				
A				
C	90°37'24"	0°00'	70.00	Set nail
J	P.O.T.	0°00'	50.00	Set nail
K	P.O.T.	0°00'	120.00	
J	89°23'			
G				