

Fd 6"x8" stone with "CS" and stardrill hole.
in fence line 2' west of north-south
fence line. Set 3/8" iron rod 0.29' W.

Fd 3/8" iron rod at
Sta 27+03.53. See County
road survey.

Fd 6"x8" stone tipped over on side.
Set 3/8" iron rod at relocated location.
at fence intersection. This point
is 283.07' N 3° 09' W of NW cor.
J. P. Friedley D.L.C. 62 per C.S. 270,
plat sheet 11-5, 28

Astronomic
North


C.S. 3794

Survey for
CHATEAUX MODERNES, Inc.

D.L.C. 54, 55 & 62,
T.115., R.5W., W.M.
Benton County, Oregon

Scale 1 in. = 100 ft
April 1963

C.W. Dane
Corvallis, Ore.

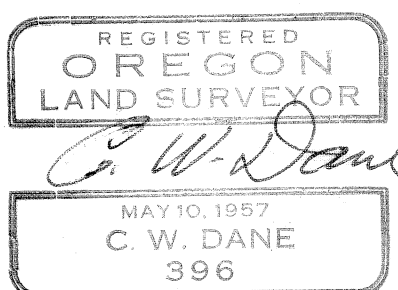

Survey by Fred
Lemke for Sally
Friedman, Dec 8, 1962