

Section

Township 11

Range 5

Scale:

Chains to the Inch.

Field Notes recorded at page

, Vol.

, Record of Surveys.

Field Book 11 - page 21 -

380

Sketch Map of

C.S. 136


1" = 200'

T 11 S R 5 W April 30

FB 11-21 1913

21

22

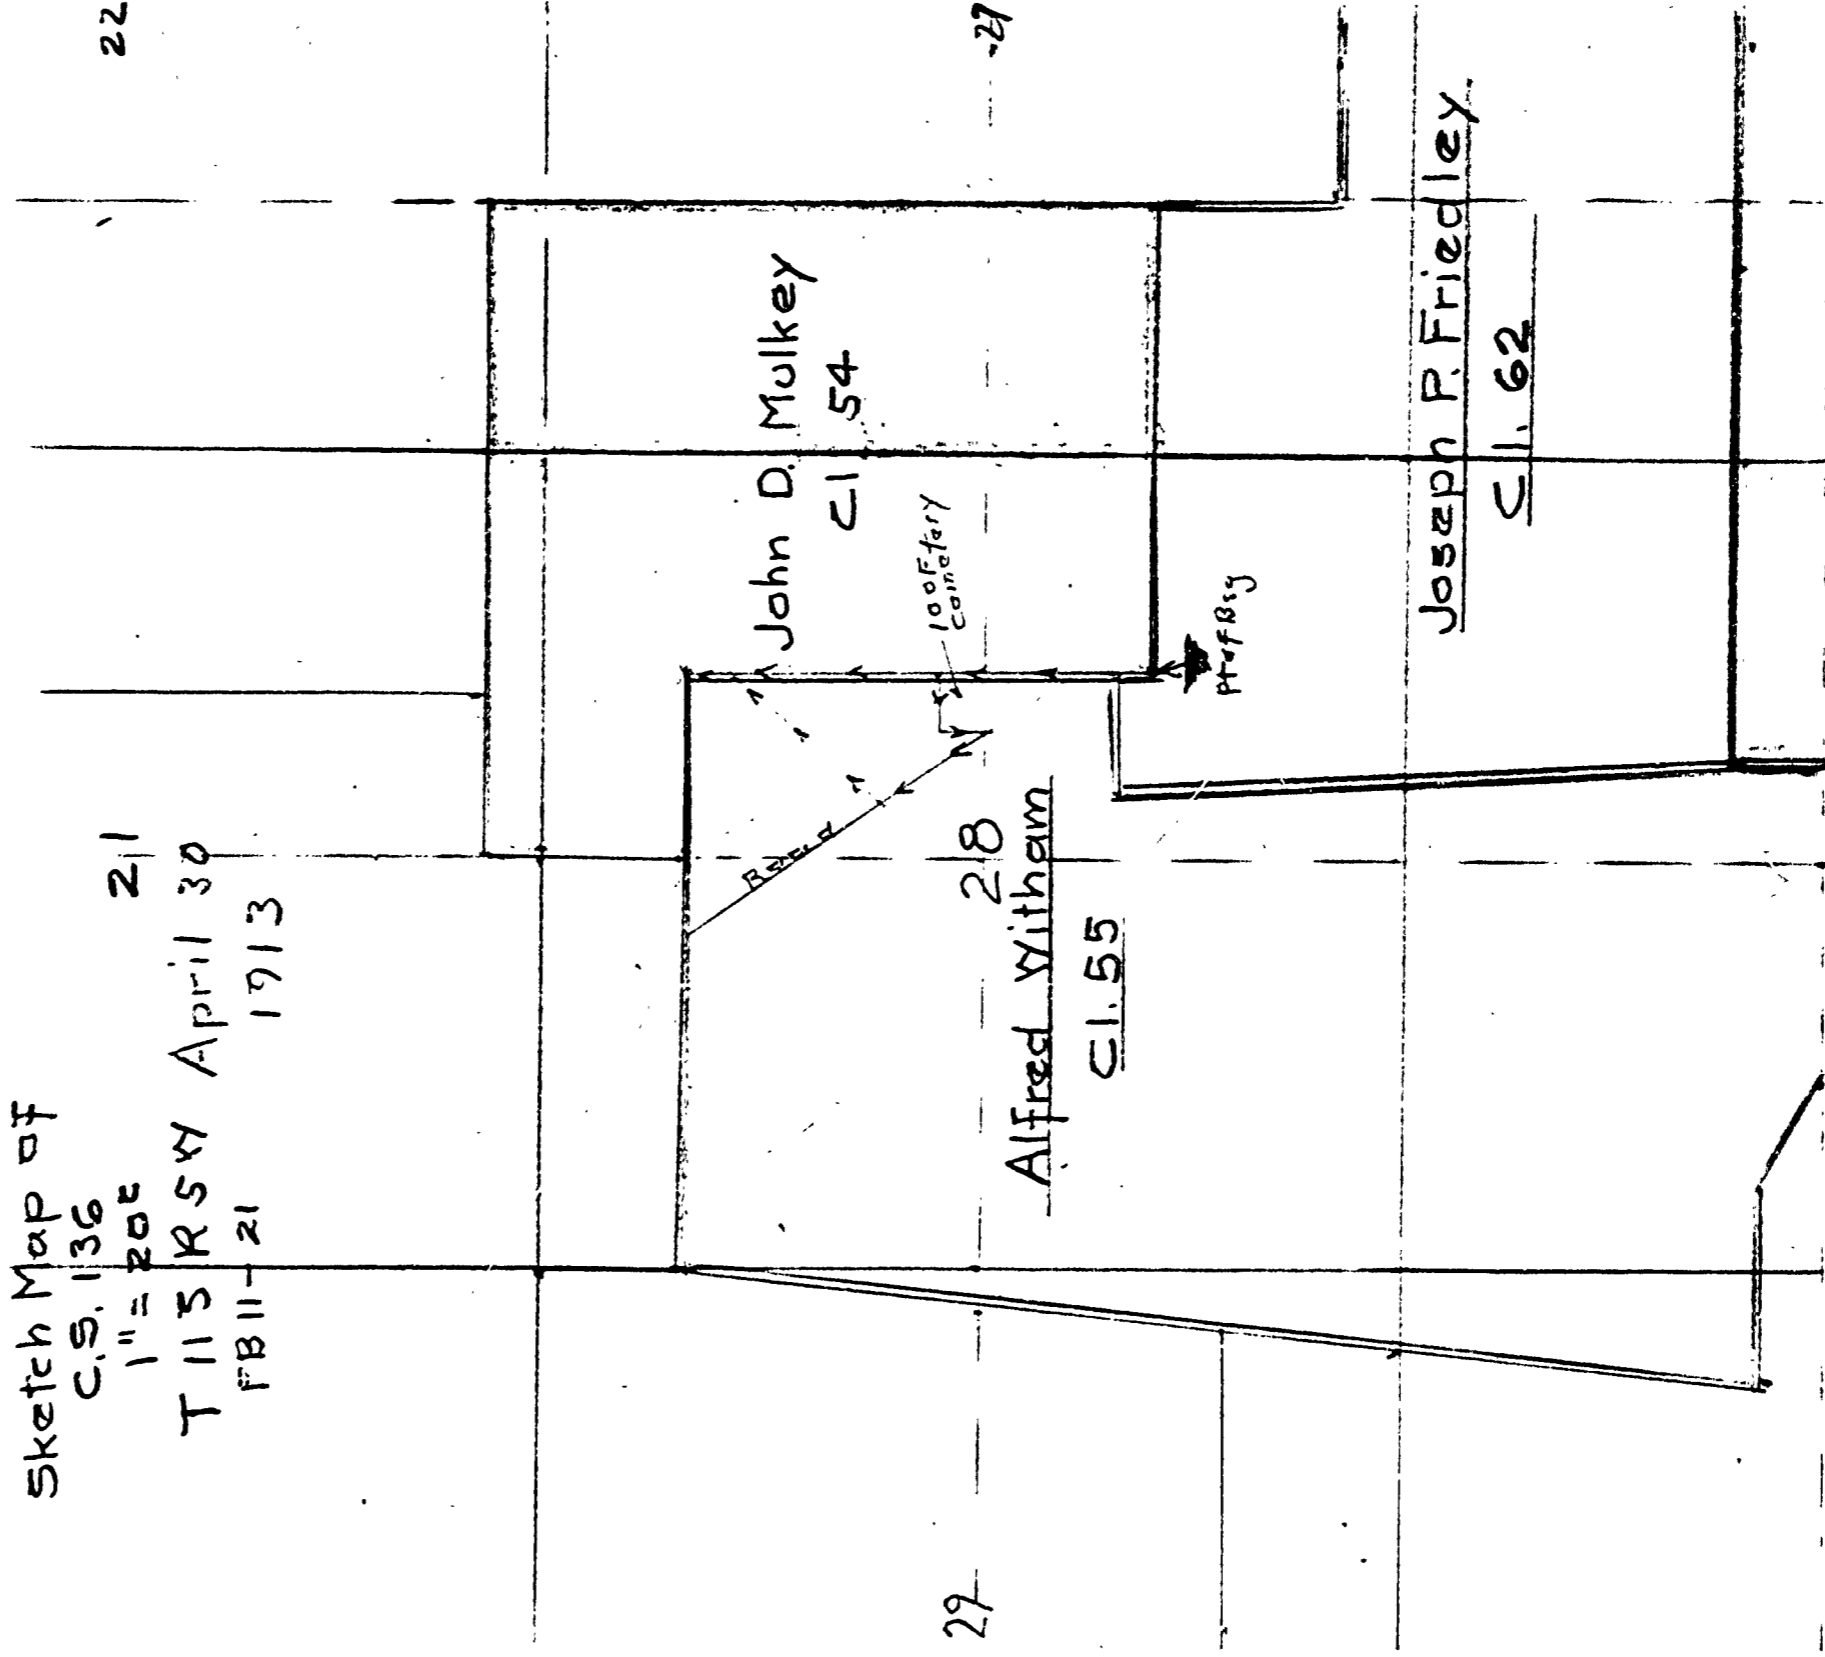

Book 11-

MINING
RAJSHI BOOK

368

11

#880 Survey No 136-

John J. McCreary D.L.C. (od. etc)

- Line North + 44
- Δ 2 40° 40' Apple R - 30' + 20' → 76.592
- Δ 3 New County Co. North → 2.655
- Δ 4 20' → 3.735
- Δ 5 07' from N.W. Co. → 2.00
- Δ 6 15' → 8.580
- Δ 7 15' → 7.614
- Δ 8 North Co. → 5.708
- Δ 9 168' → -168'

Striking East .072

Back to A 3 - Striking East + W. 1.228

W. 89° 30' W. 5.230

Δ 8 34° 16' W. 4.166

Δ 9 14' 34' 30' 7.00

Δ 10 N 41° 23' E - 6.649

Δ 11 - 2.828

Δ 12 - 2.898

Δ 13 5.310

Δ 14 2.819

Δ 15 2.898

Δ 16 5.304

Δ 17 17.859

Δ 18 17.90ms

Monday 5.708

Tuesday 76.099

Wednesday 51.372

Thursday 5.137

Friday 58.547

Saturday 6.5756

Sunday 12.167

Monday 2.35

Tuesday 4.166

Wednesday 6.999

Thursday 3.749

Friday 3.74

Saturday 4.177

Sunday 4.30

Monday 6.444

Tuesday 10.699

Wednesday 5.984

Thursday 3.98

Friday 2.6

Saturday 6.645

Sunday Time

Monday 2.819

Tuesday 2.898

Wednesday 5.304

Thursday 17.859

Friday 17.90ms

Saturday 4.166

Sunday 6.998

Monday 4.166

Tuesday 6.998

Wednesday 4.166

Thursday 6.998

Friday 4.166

Saturday 6.998

Sunday 4.166

Monday 6.998

Tuesday 4.166

Wednesday 6.998

Thursday 4.166

Friday 6.998

