


C.S. 3817
 Survey For
WHITNEY DOWNING
 In the
 Price Fuller
 Donation Land Claim
 Number 37
 Township 11 South,
 Range 5 West of
 Willamette Meridian
 Benton County, Oregon
 Scale: 1"=100' 6 April, 1963

REGISTERED
OREGON
 LAND SURVEYOR

Fred I. Lemke
 MAY 2, 1966
FRED I. LEMKE
 443

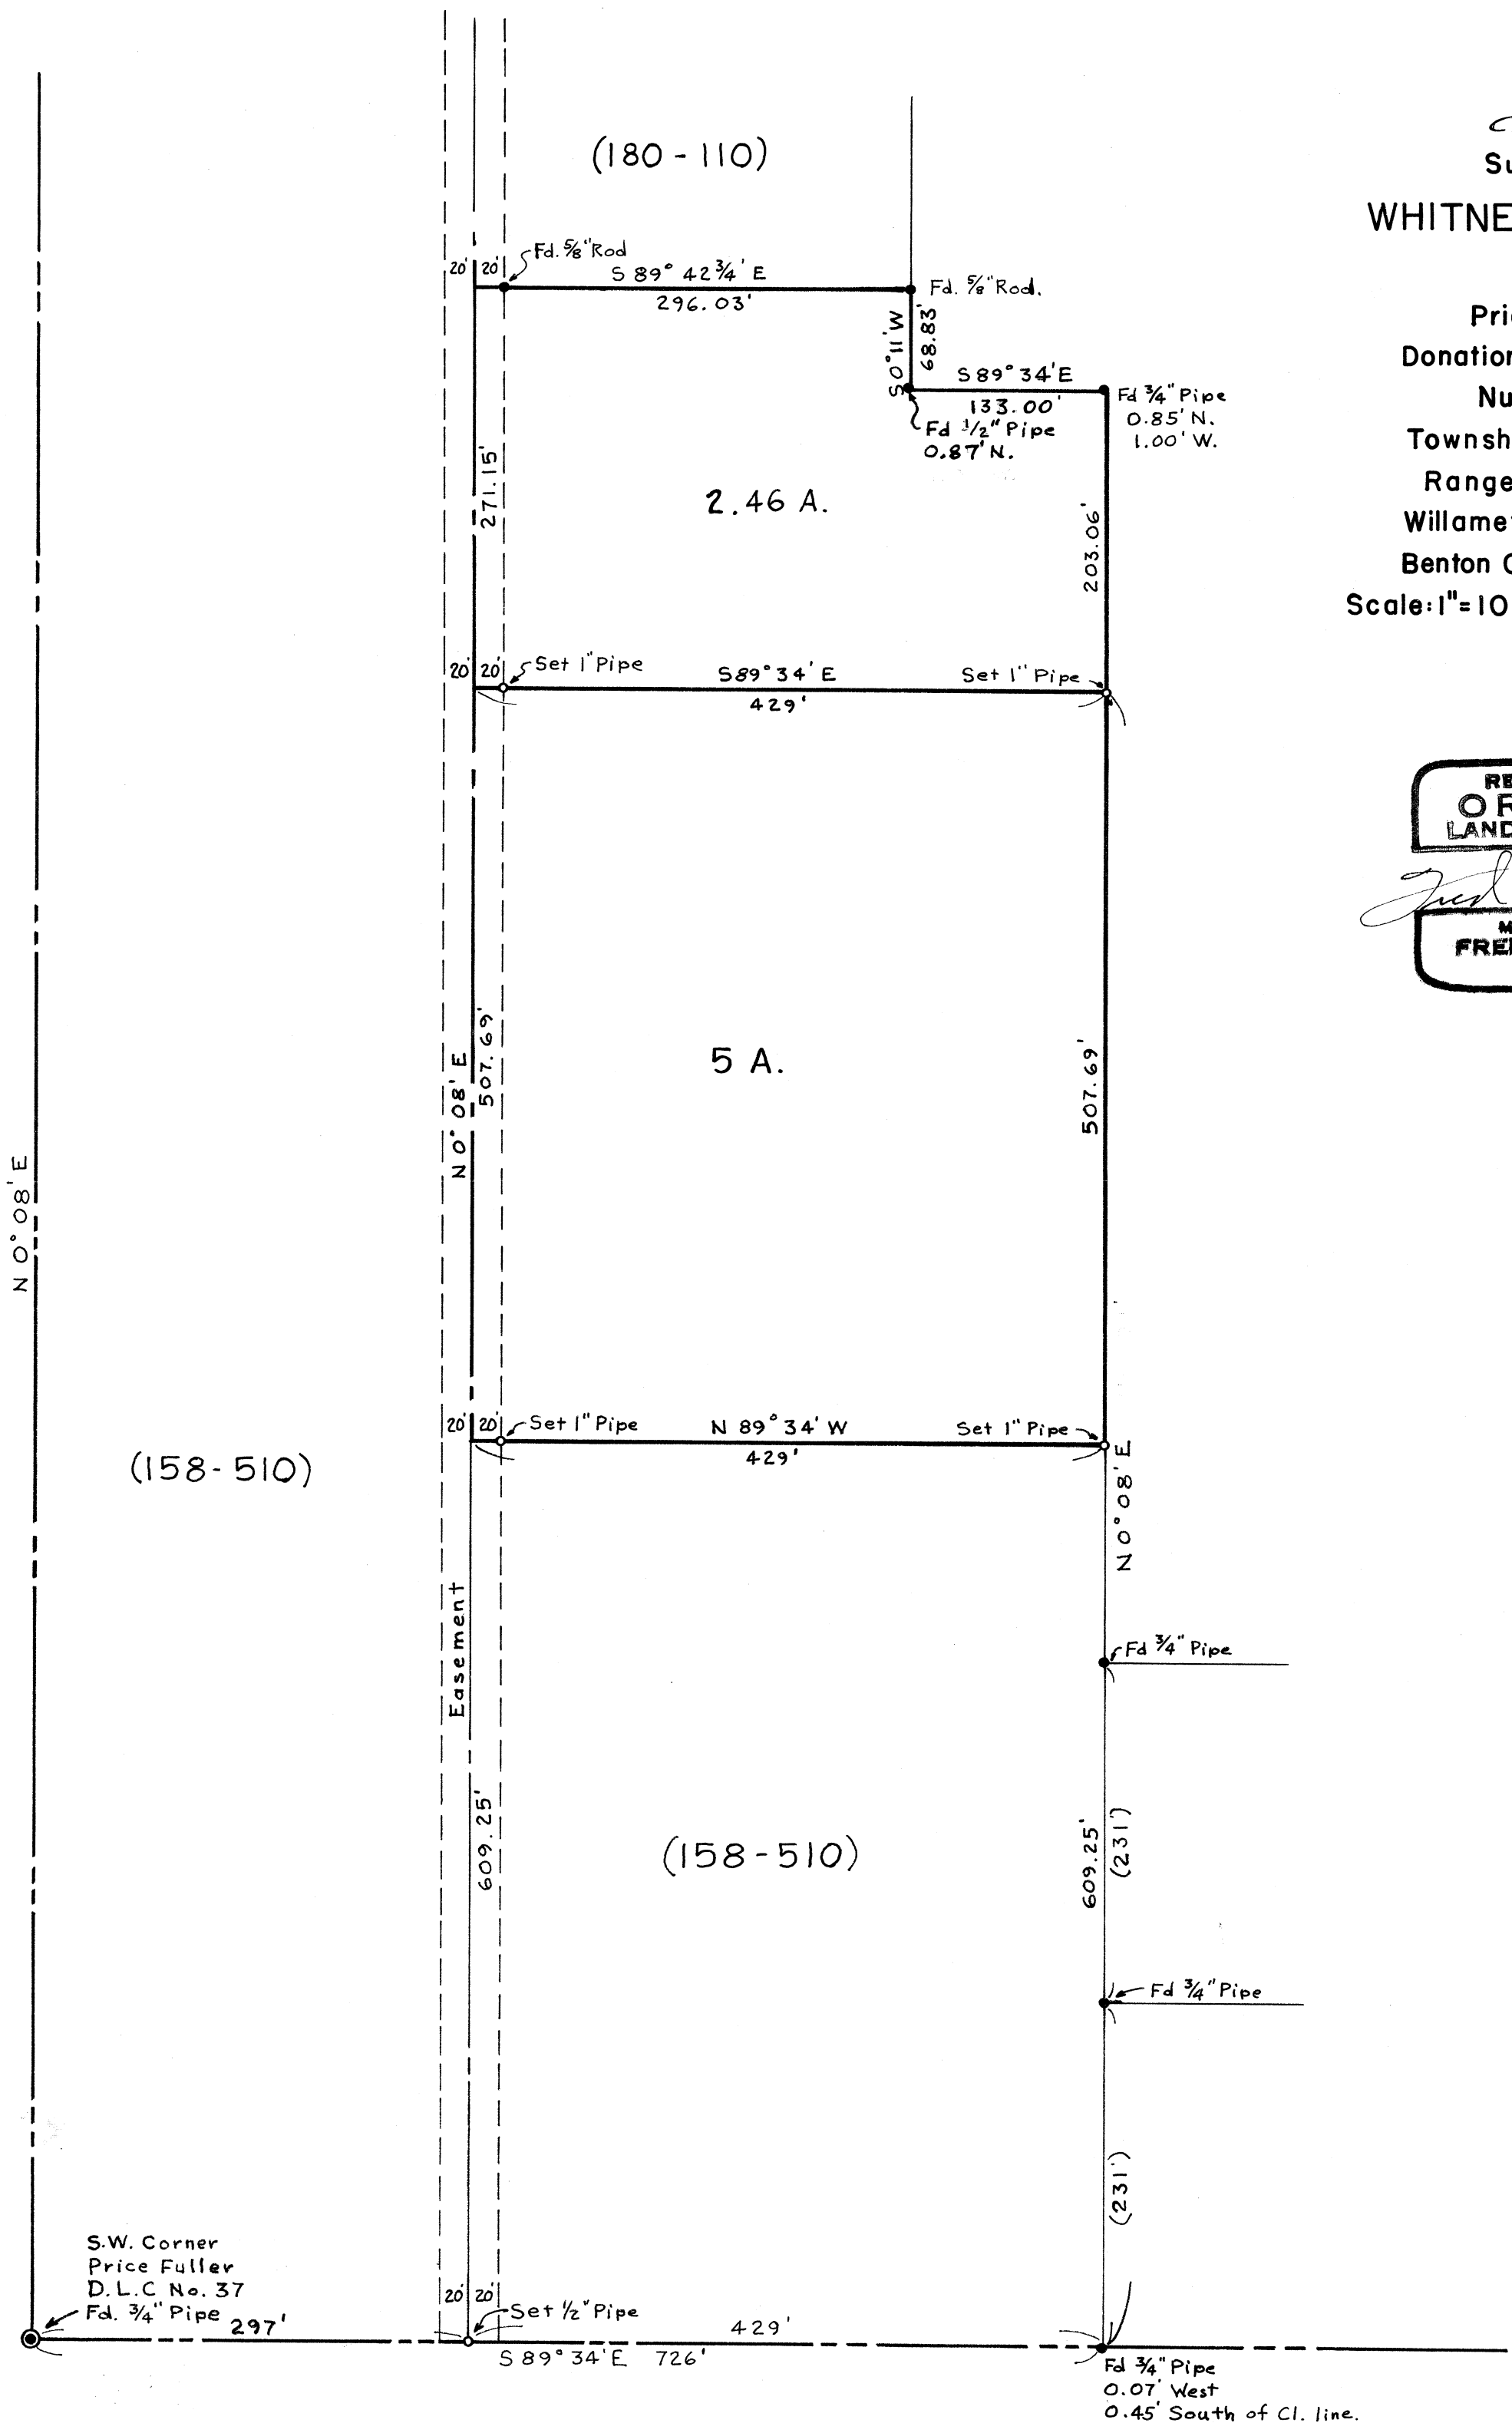

3817