

C. S. No. 3835


T. J. STARKER

JOHN TRAPP D.L.C. 44, Twp. 12 S., R. 5 W., W. B. & M.

Scale: 1" = 100'

October 23, 1963

- = 3/4" Pin Set Unless Noted.
- = Road Monuments Found.

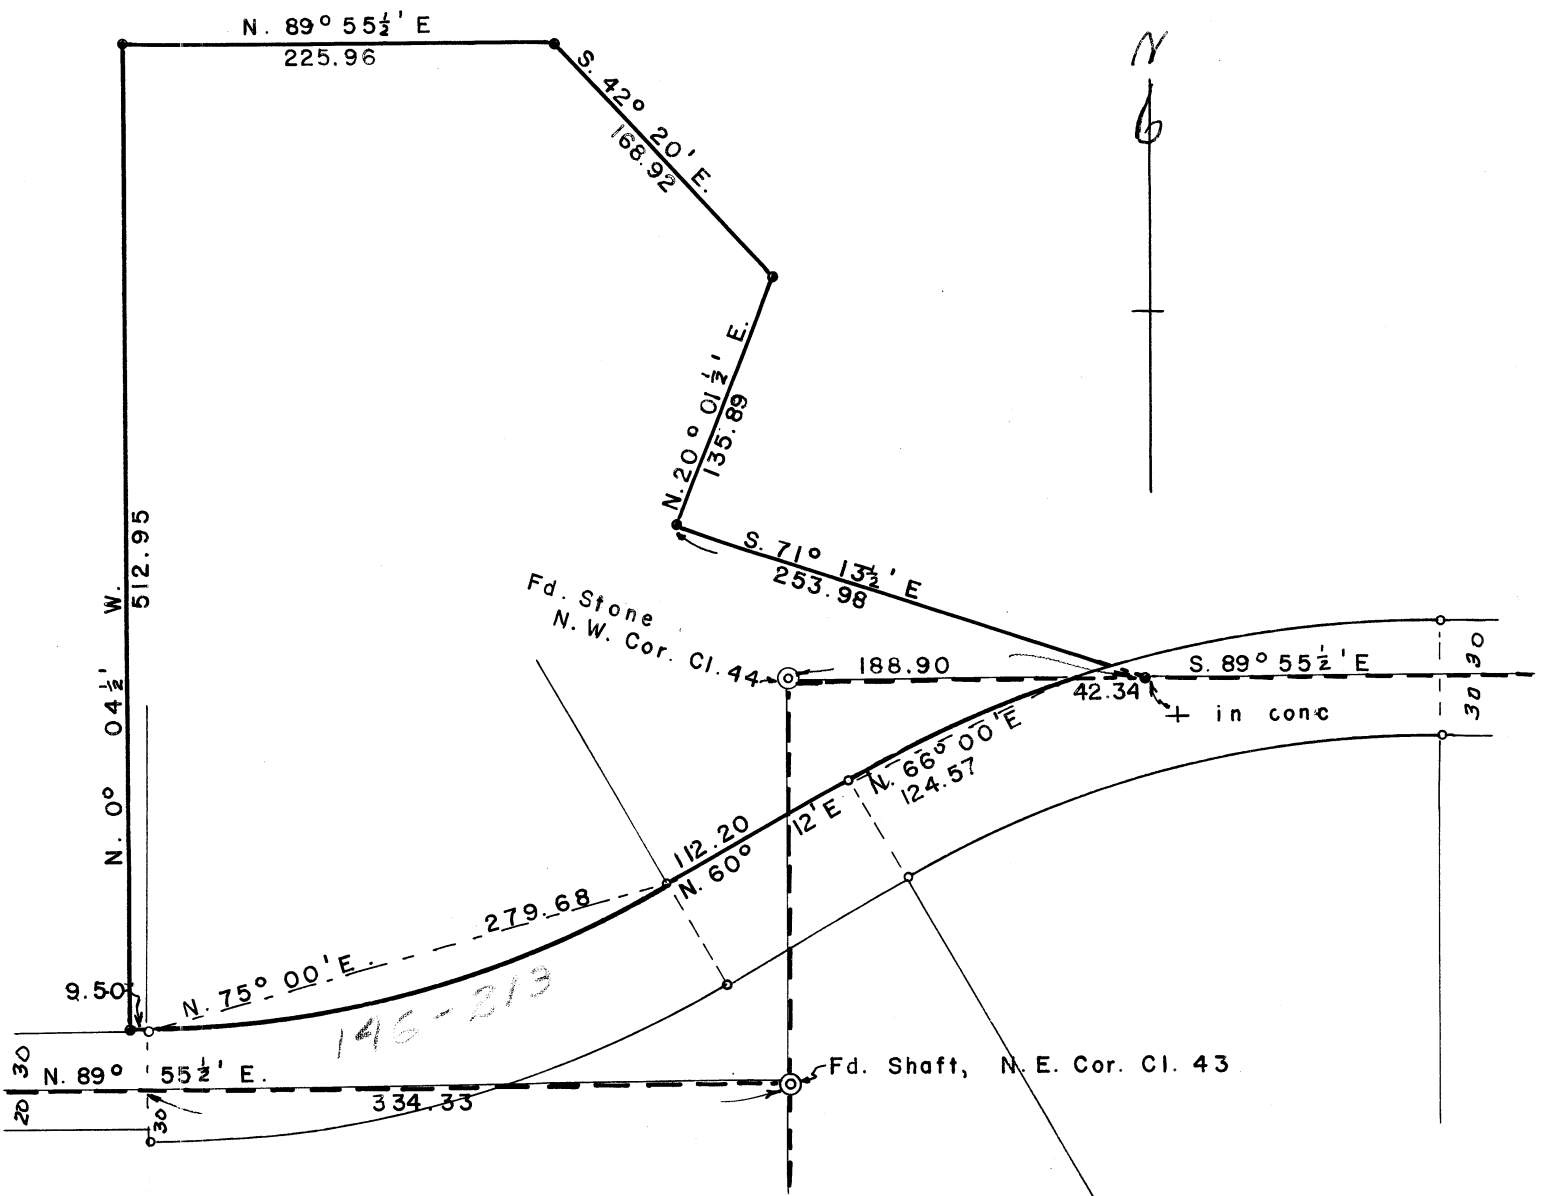

REGISTERED  
**OREGON**  
 LAND SURVEYOR

*Curtis C. Hanson*

NOVEMBER 9, 1963  
**CURTIS C. HANSON**  
 181

C 5 # 3835  
 For J Starker  
 10-22-63

Axon  
 ? ch

• = 3/4" Pin Set

