


C.S. 3937

CONSUMERS POWER, INC  
Lots 18, 19 & 20, Block 5  
AISEA, OREGON  
BENTON COUNTY, OREGON

60' MAIN STREET 60'

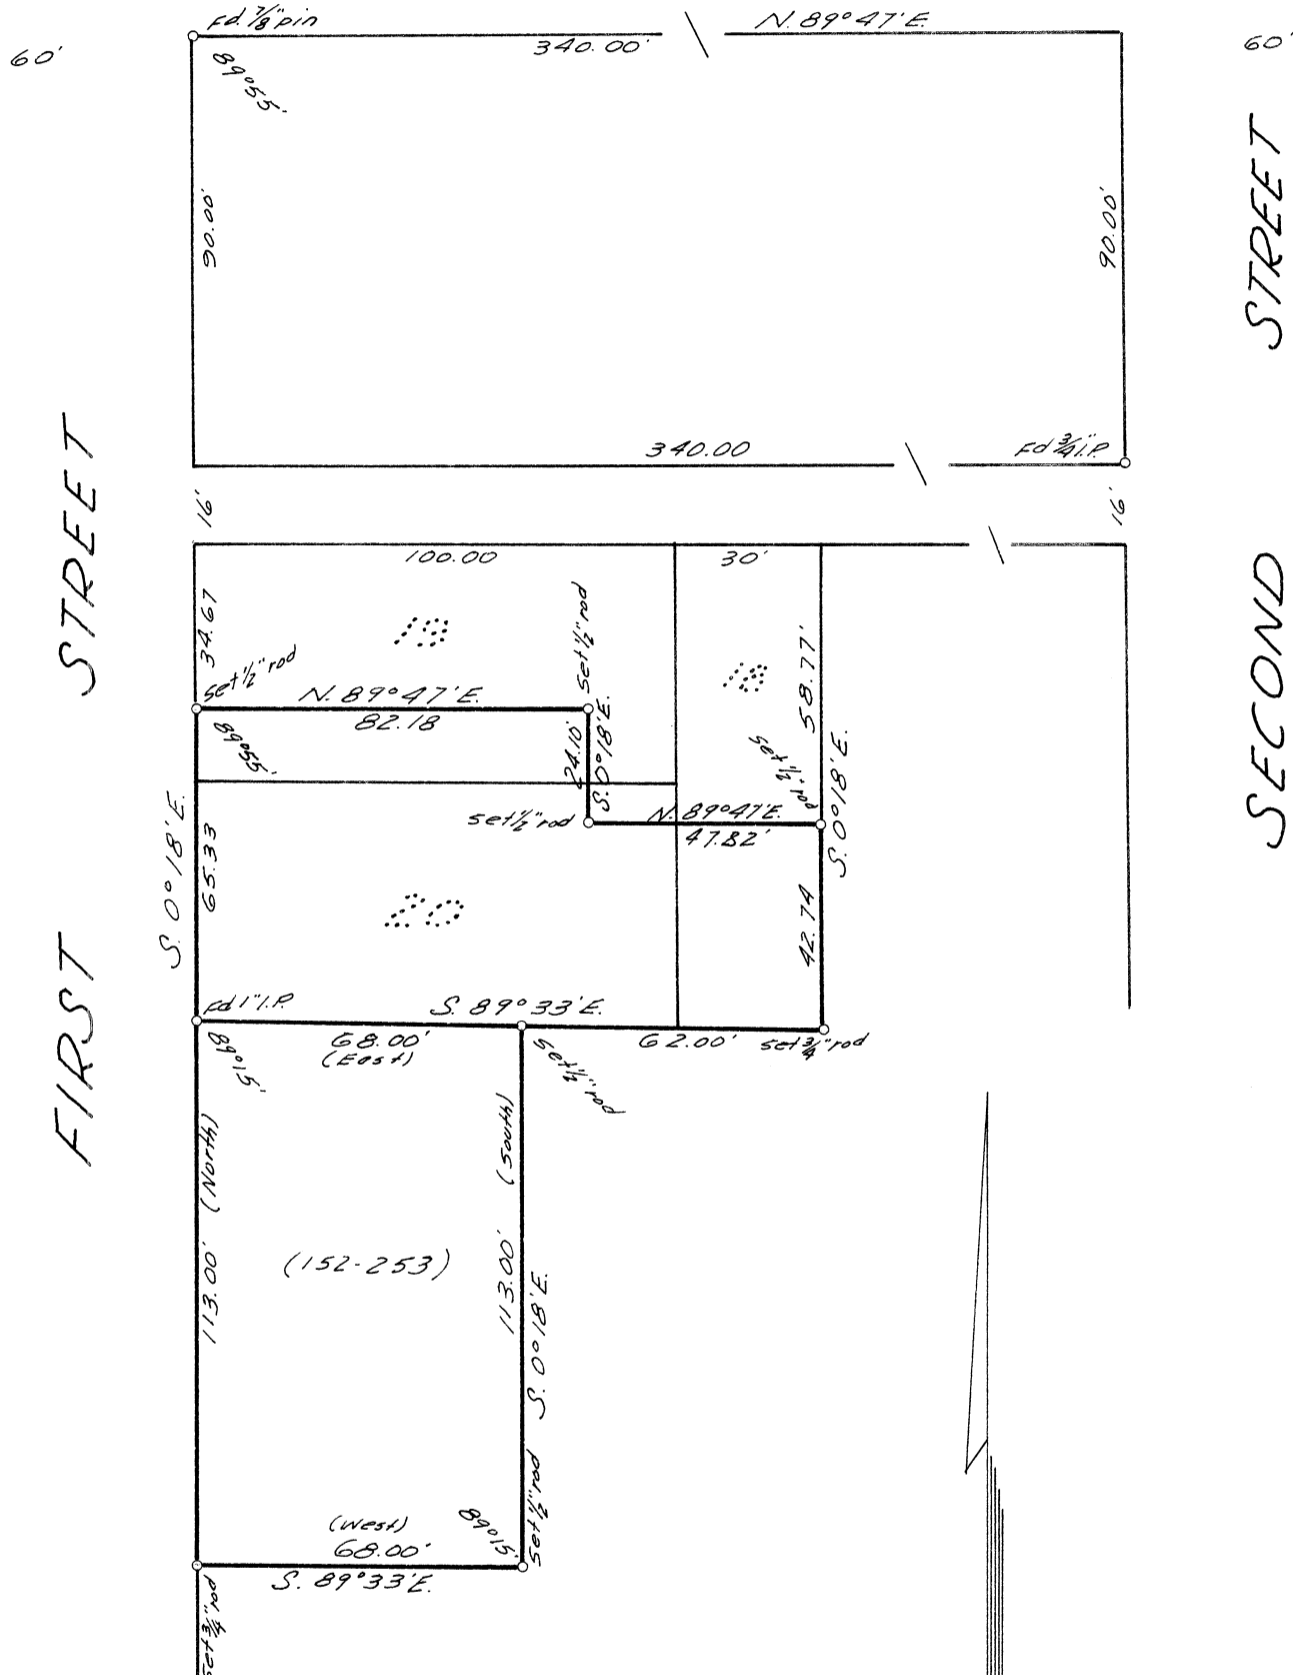

FIRST STREET

SECOND STREET

1" = 40'  
June 10, 1964

REGISTERED  
 SURVEYOR  
 LAND DIVISION  
 OREGON  
 Richard W. Fair  
 RICHARD W. FAIR  
 SURVEYOR