


C.S. 3985
 RECORD OF SURVEY
 EARL ASBAHR
 JEHIAL S. KENDALL CL. 48
 T.I.S., R. 4W., W.B. & M.

N.W. Cor.
 D.L.C. N^o 48

SCALE 1" = 100'
 SEPT. 21, 1964

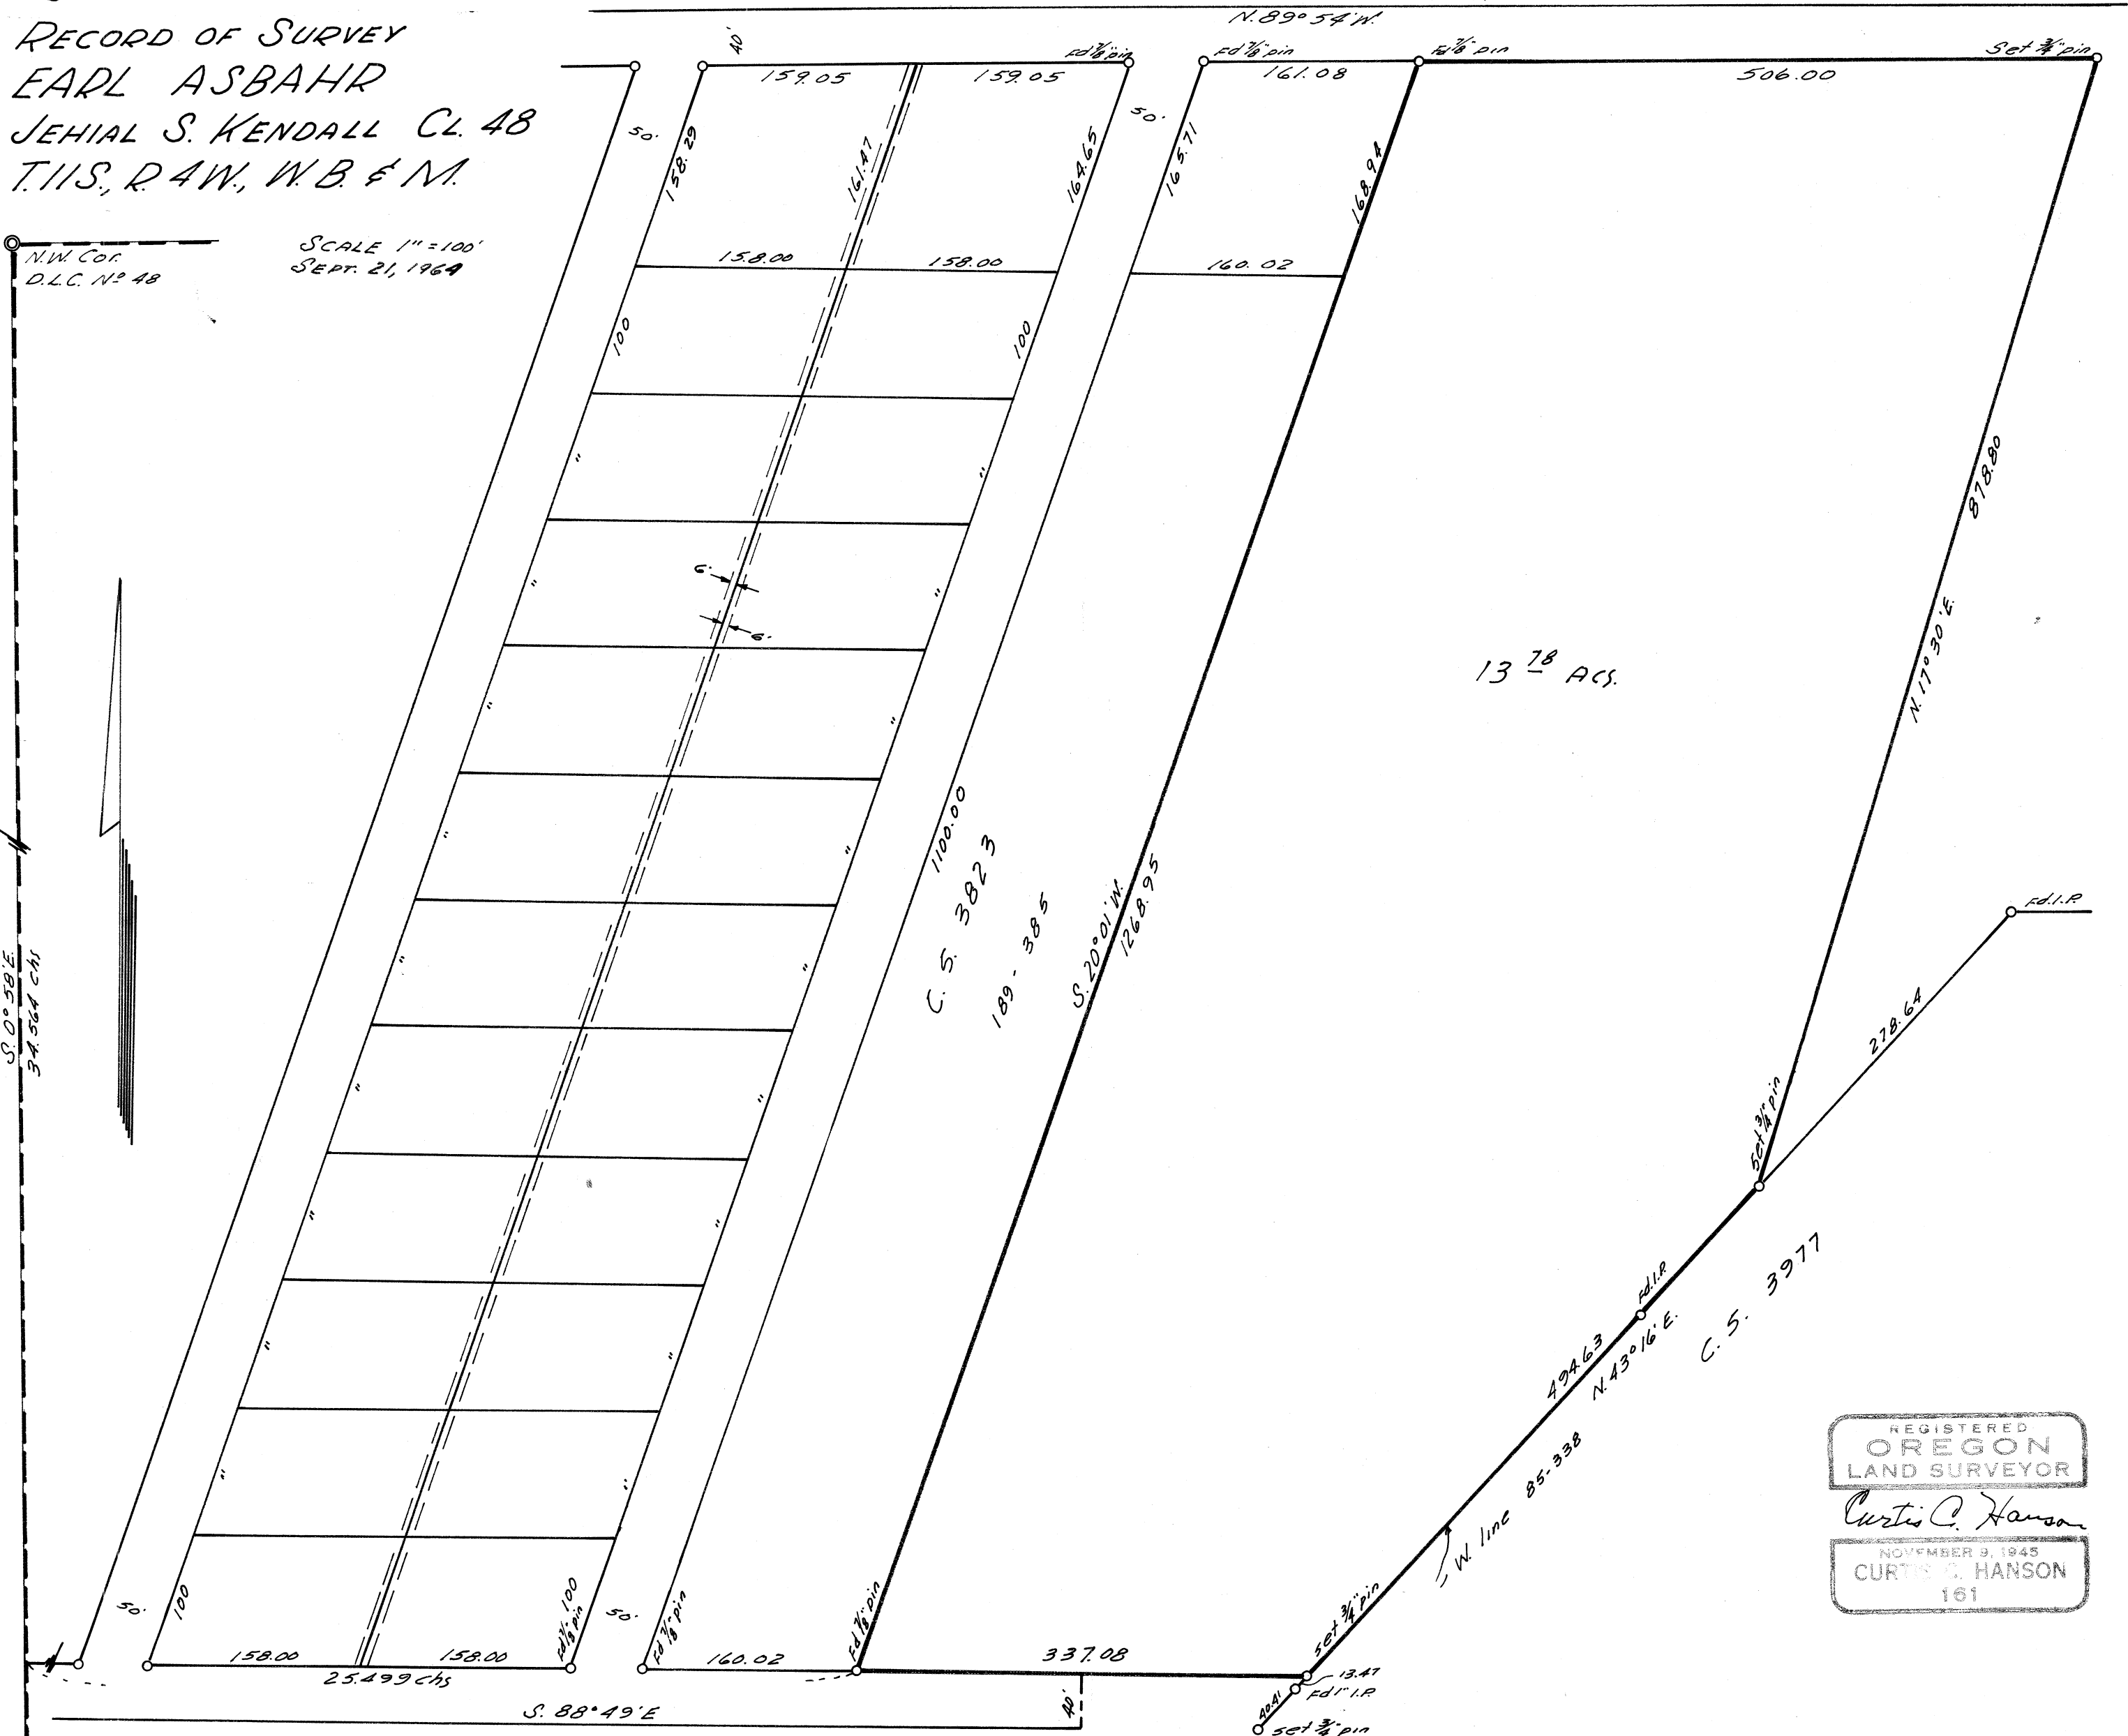

REGISTERED
 OREGON
 LAND SURVEYOR
 Curtis C. Hanson
 NOVEMBER 9, 1945
 CURTIS C. HANSON
 161