



CS 4034

# PIONEER TELEPHONE COOP.

## Lot 125 Block 31 O.T.

### Philomath, Oregon

Feb. 10, 1965

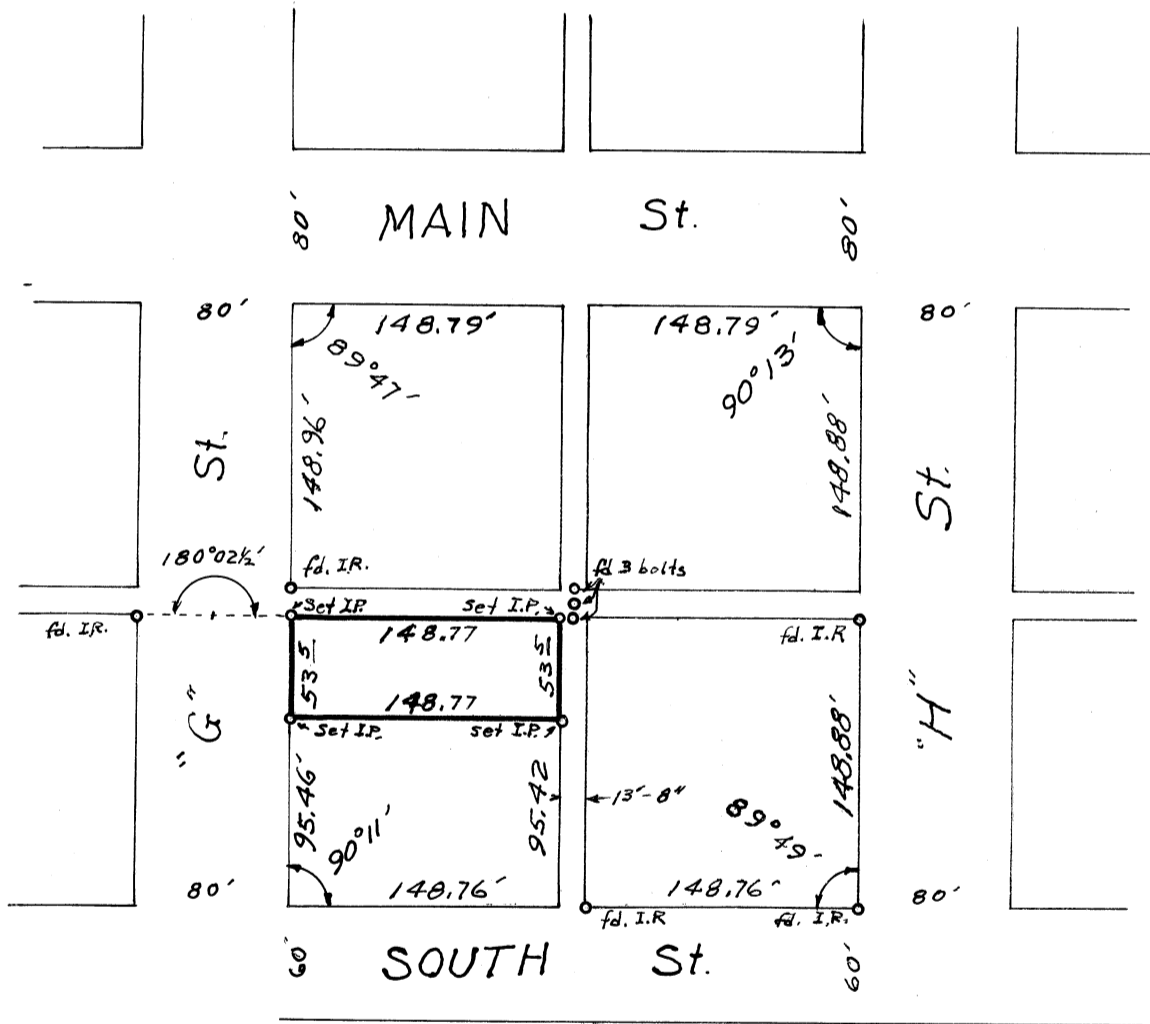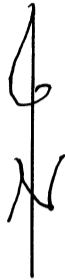

Scale: 1" = 100'

REGISTERED  
OREGON  
LAND SURVEYOR

*Martin L. Beyerlein*

NOV. 5, 1948  
MARTIN L. BEYERLEIN  
247