

SURVEY FOR

FORREST S. BAKER &

JOHN C. DECIUS


A Portion of Lot 10, 11, 12, & 13, Block 1

Fairhaven Heights No. 2


Benton County, Oregon

Scale: 1" = 40'

Feb. 20, 1965

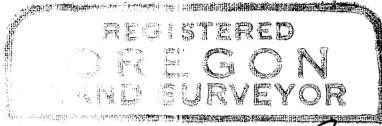

Fred I. Lemke

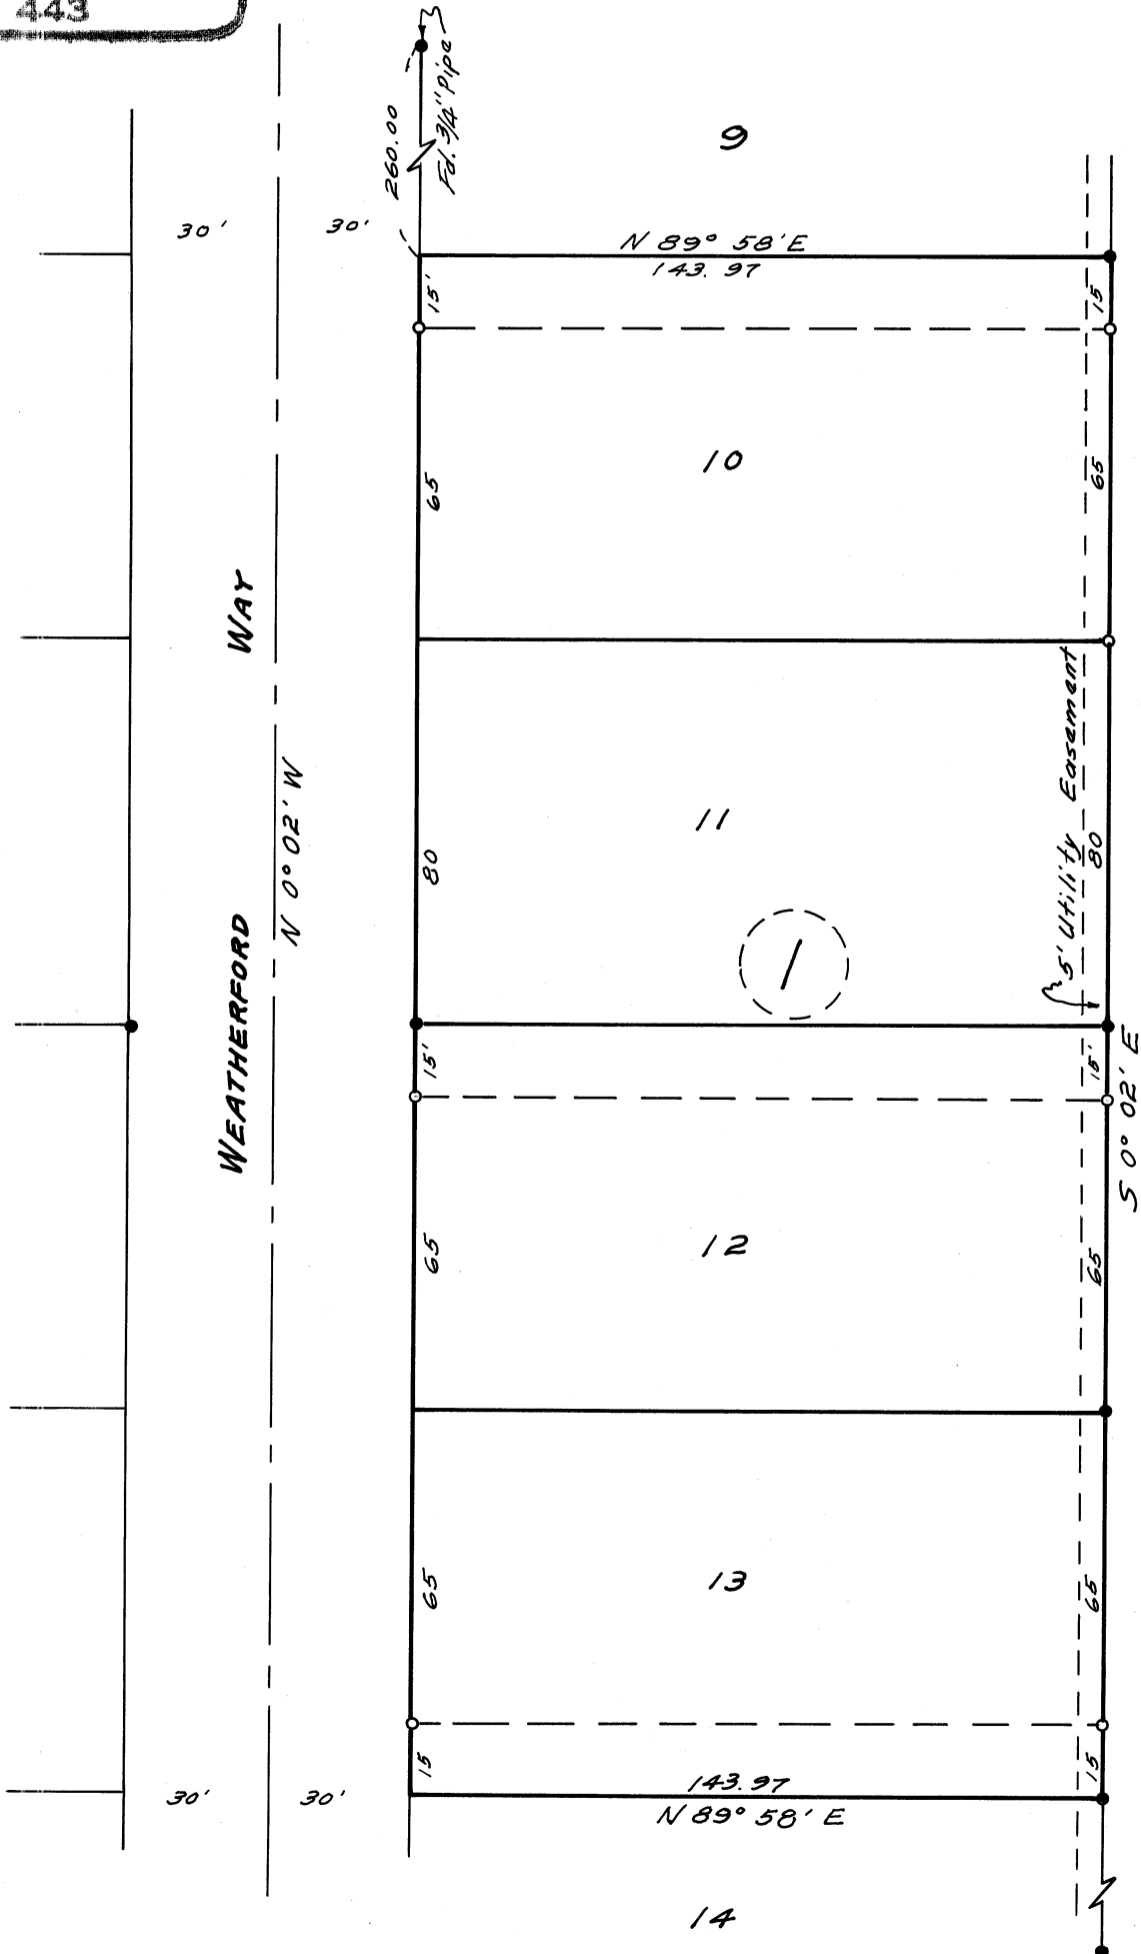

○ Denotes 1/2" Pipe Set
● Denotes 1/2" Pipe Fd.