


C 5 4094
 Record of Survey
 for
 TRIPP & TRIPP REALTORS

in the
 John Q. Thornton D.L.C. 37
 S.W. 1/4 of Sec. 36, T.10S., R.4W. W.M.
 Benton County, Oregon

Scale 1" = 100'

June 3, 1965

4094

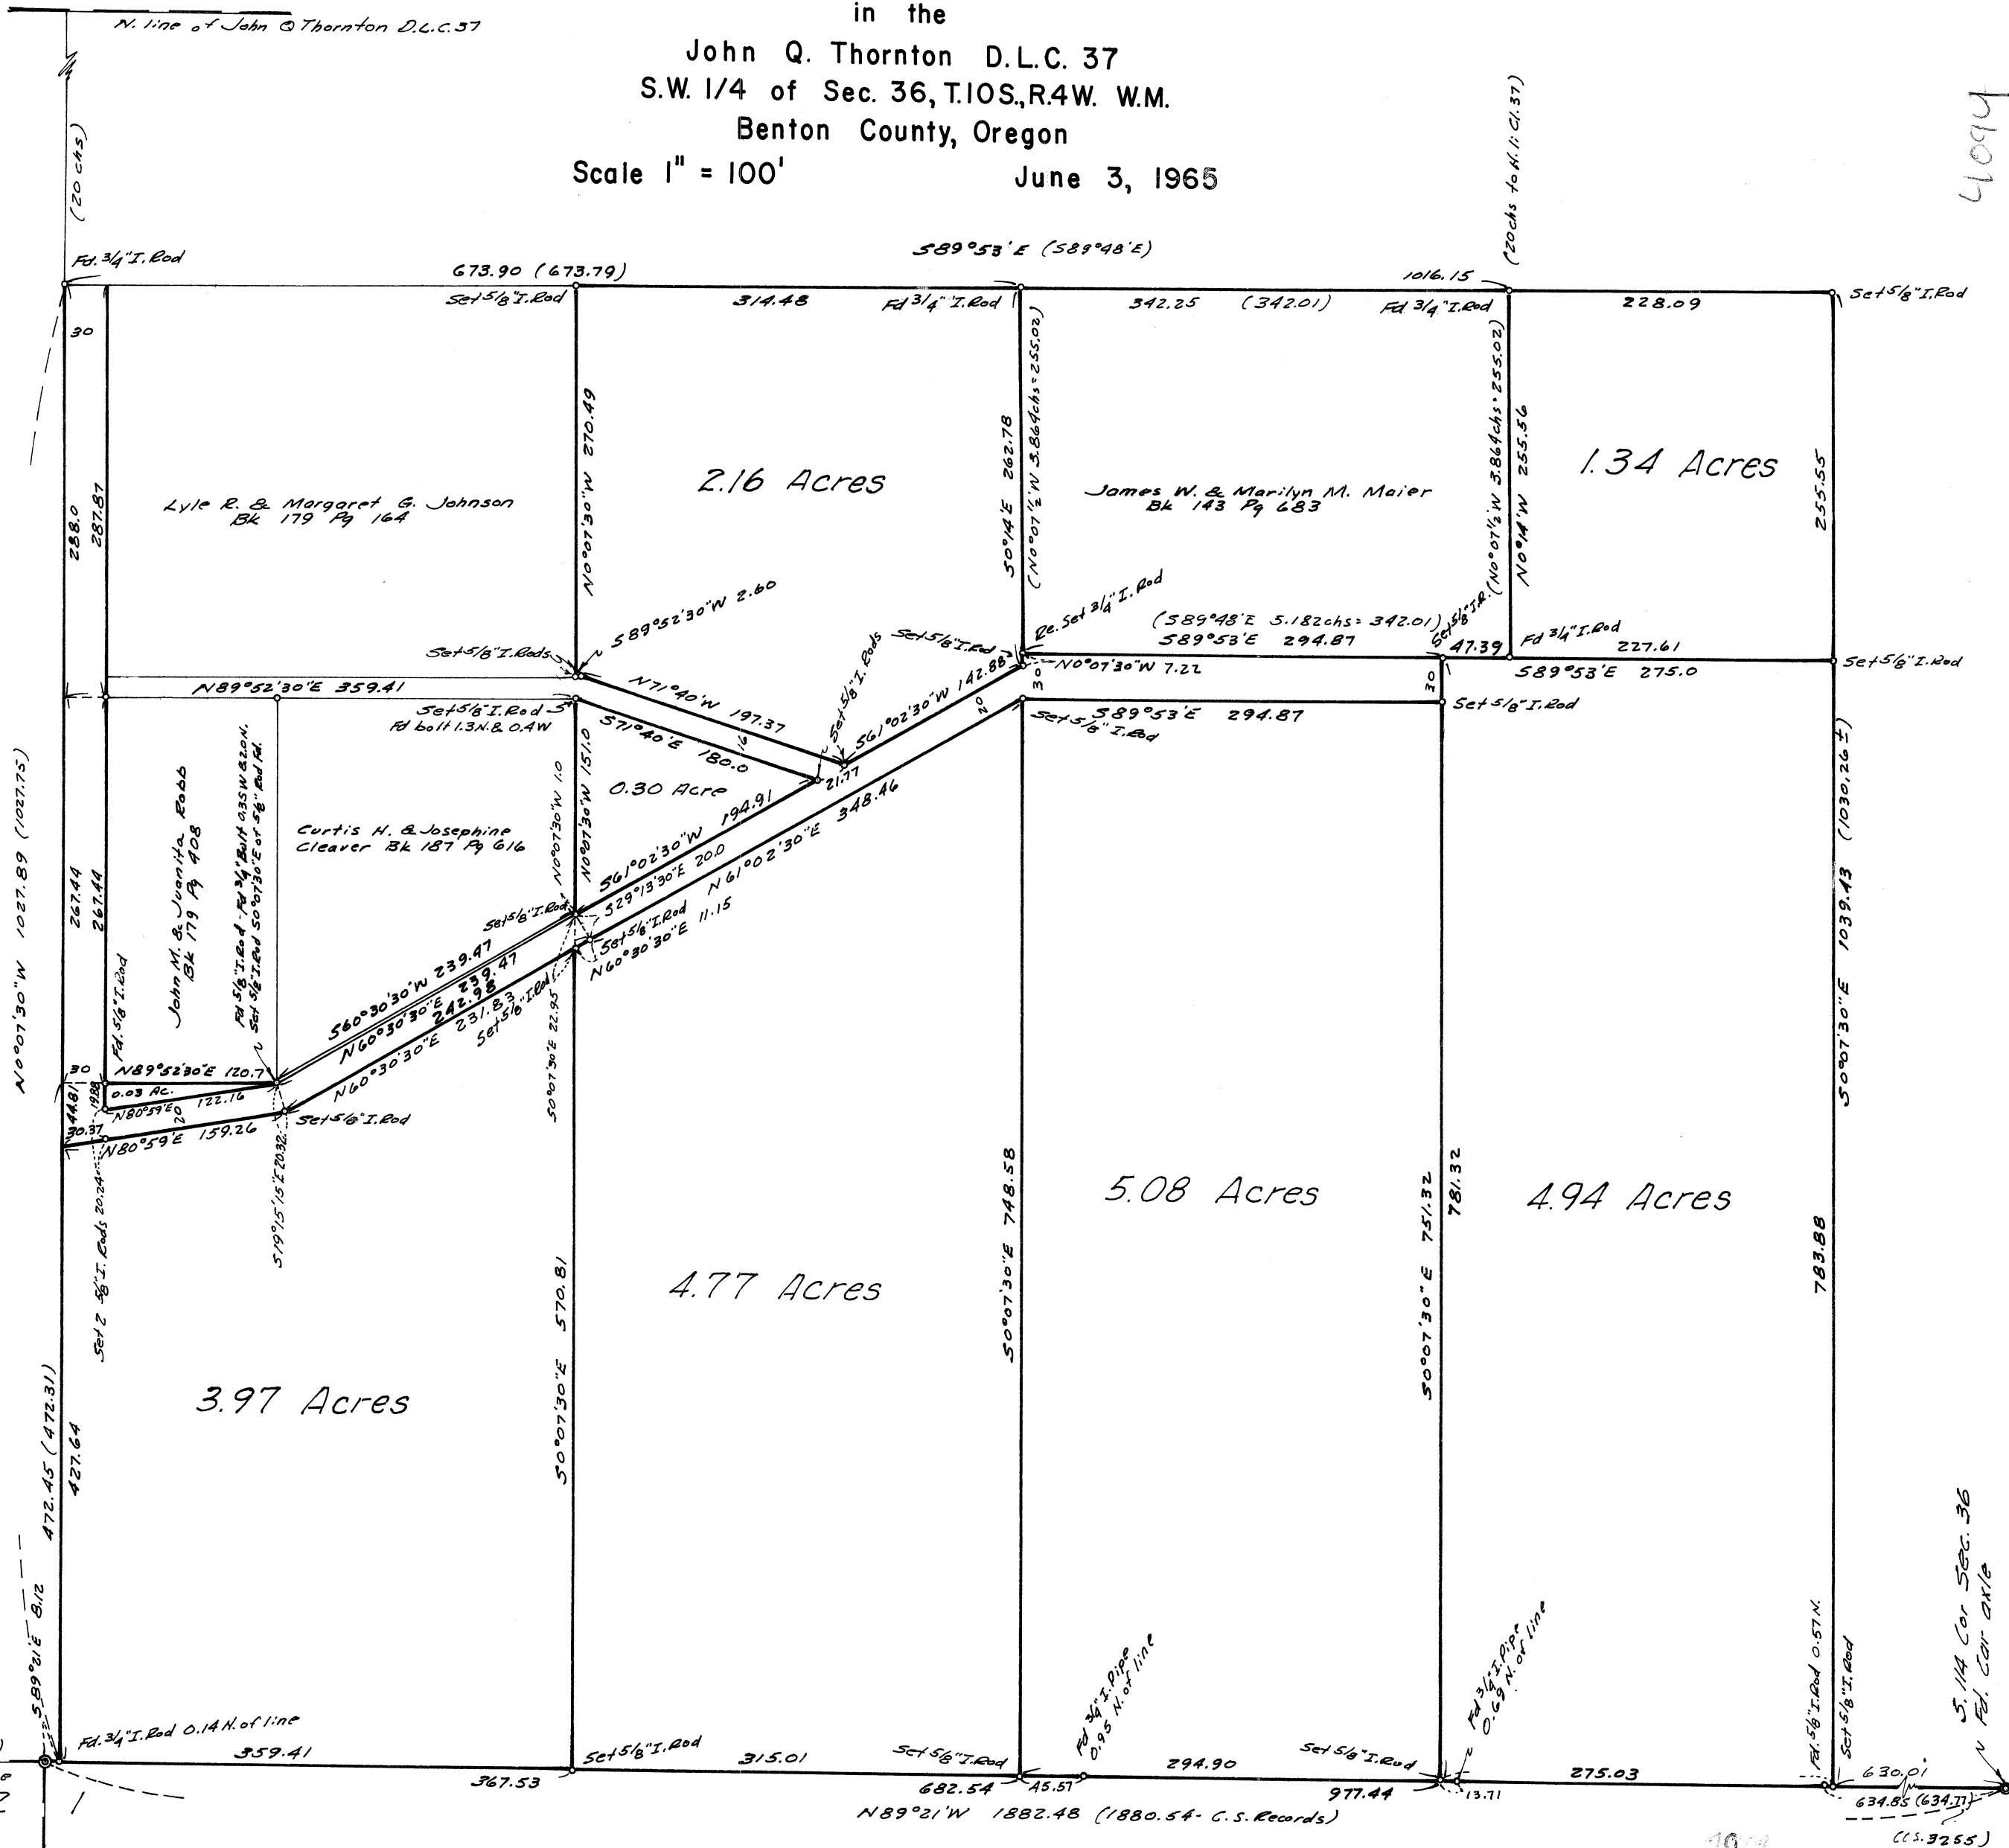

Bearings from C.S. 2507

REGISTERED
 OREGON
 LAND SURVEYOR
 Verle C. Moore
 MAY 13, 1960
 VERLE C. MOORE
 501

West Southwest Corner
 John Q. Thornton
 D.L.C. 37

S. 1/4 Cor Sec. 36
 N Fd. Cor. 216