


4152
C.S. 4152

AL OBERSON
SEC. 2, T. 11 S., R. 4 W., W.M.
BENTON COUNTY, OREGON
scale: 1" = 100' Oct 1, 1965
B. Osburn Shaw
O.L.S. # 431

WEB
O.P.
B. Osburn Shaw

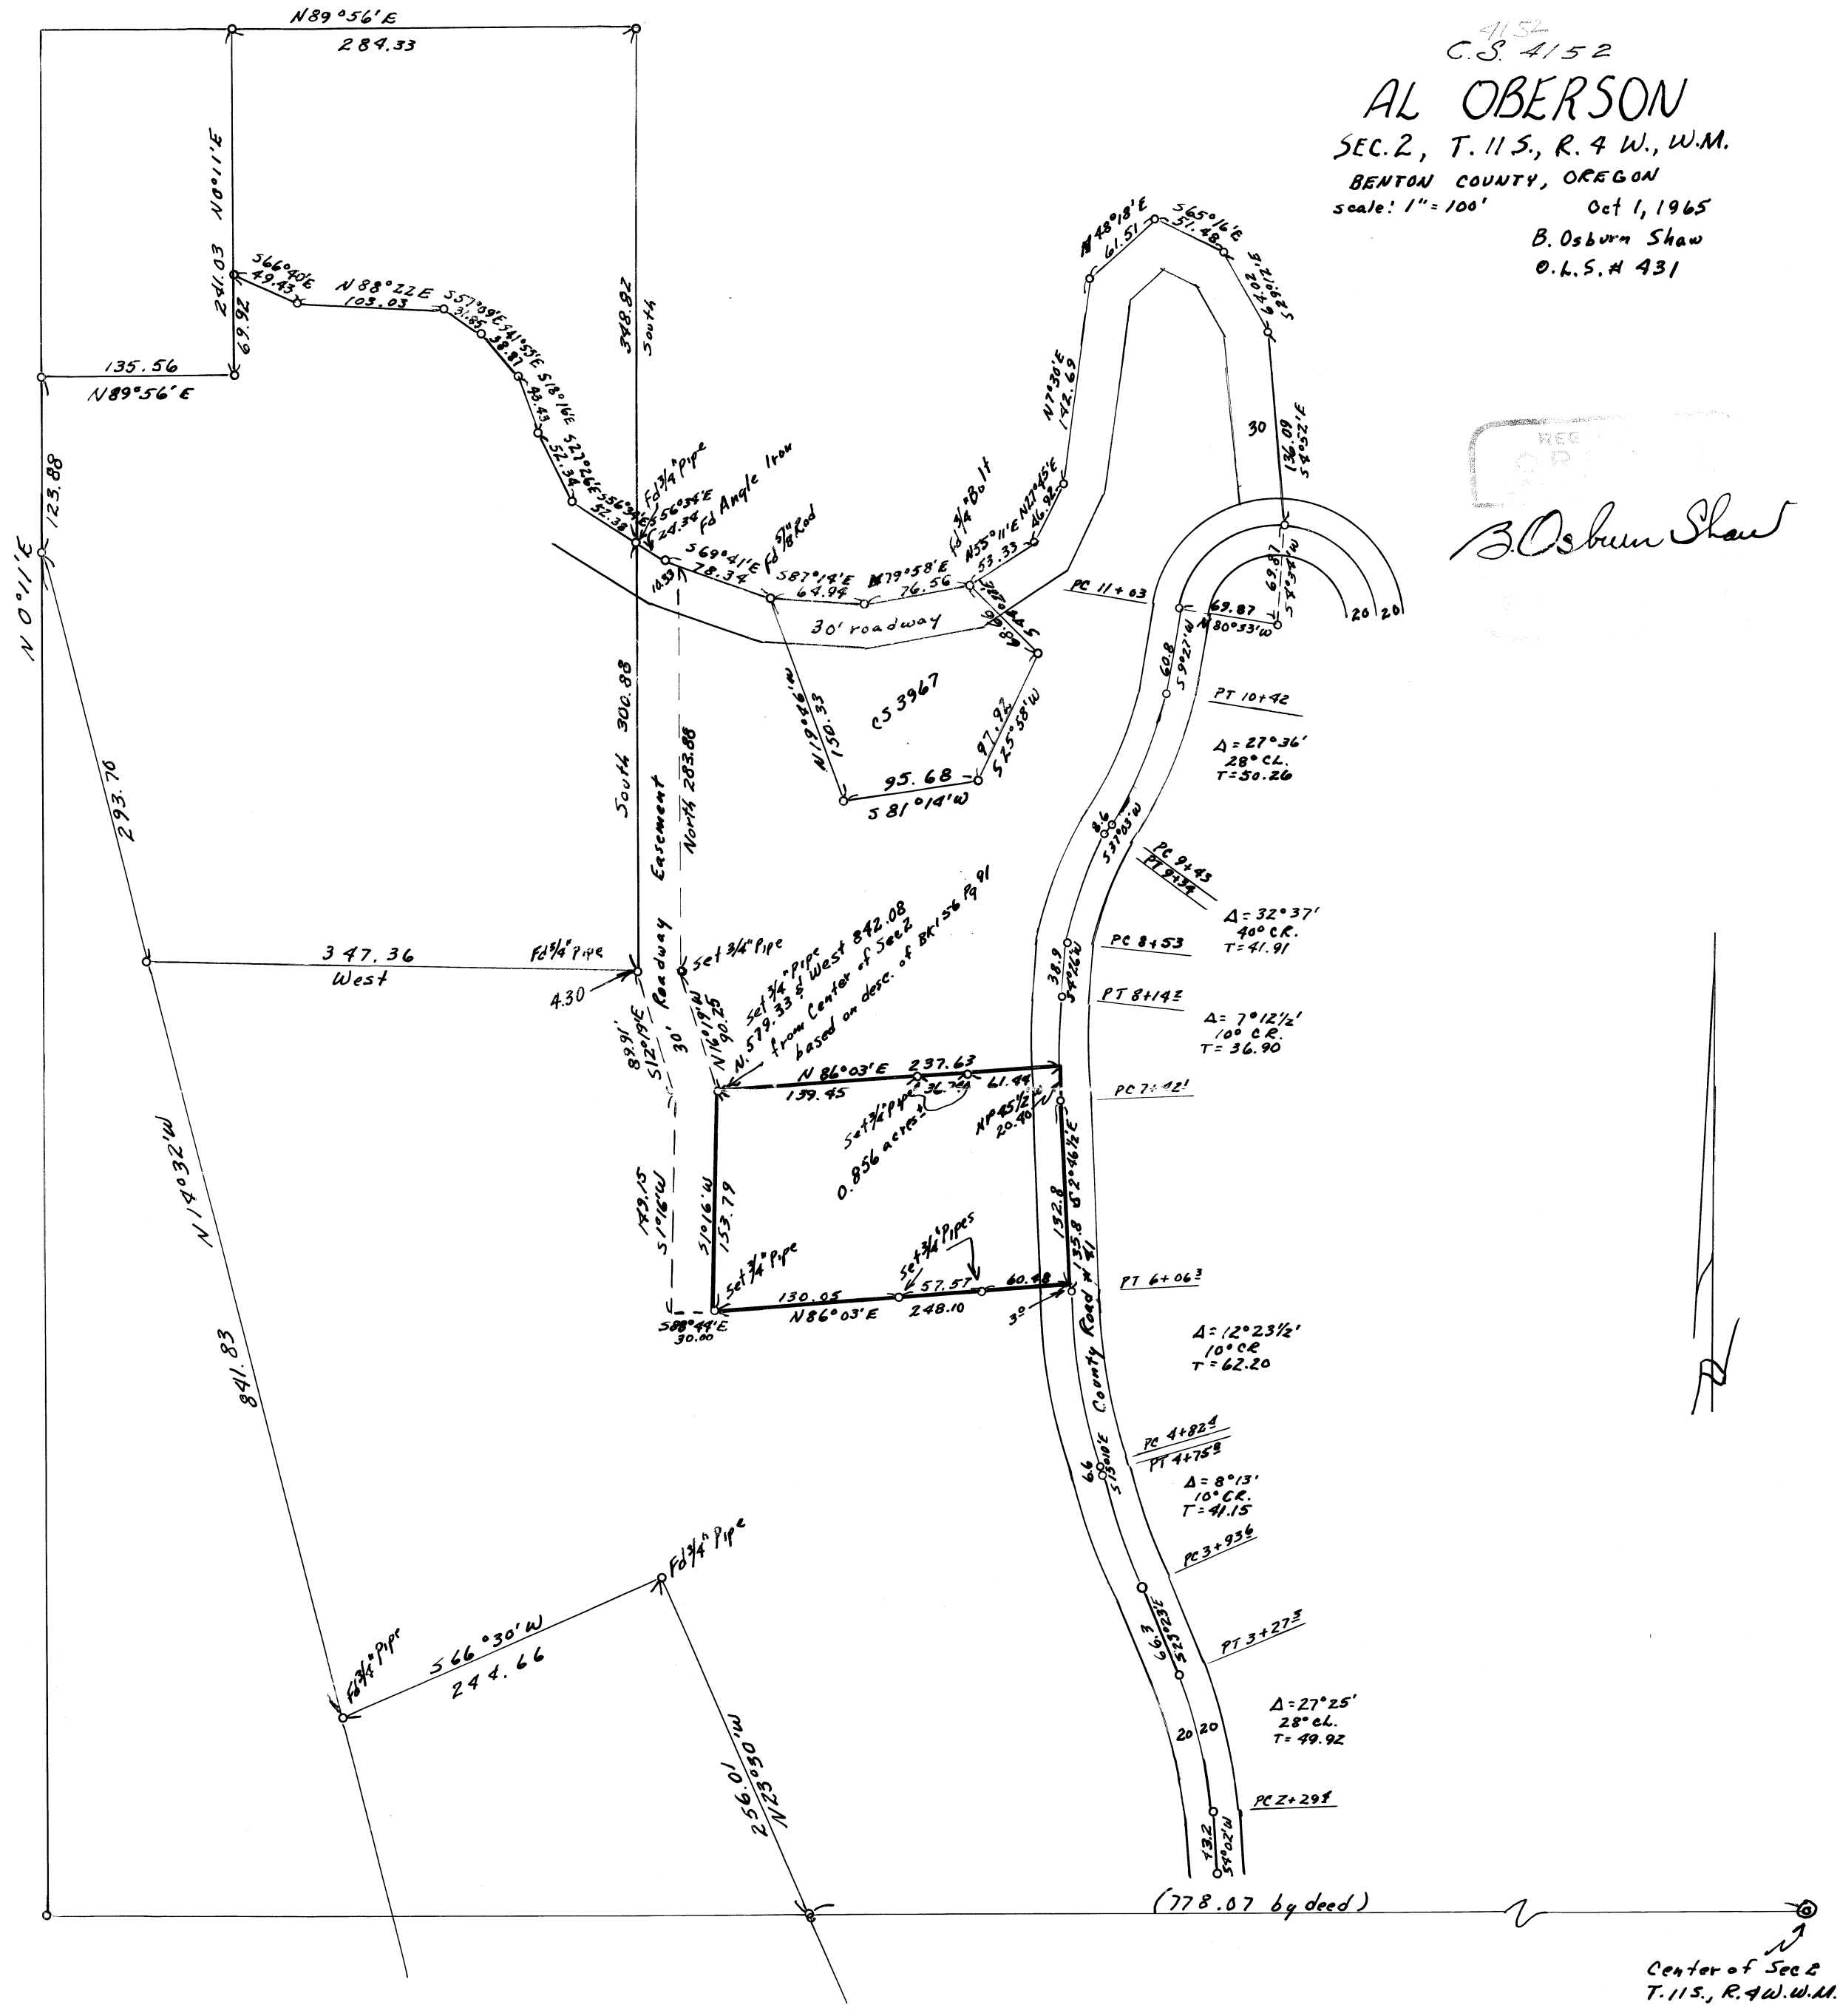

4152